

MARSHALL
 U 2000
 10-8-75

MISSISSIPPI
 BOARD OF WATER COMMISSIONERS
 416 North State Street
 Jackson, Mississippi 39201

WATER WELL DRILLERS LOG

Oct. 8 1975 R. L. Carpenter Marshall
 date well completed firm name county well located

LANDOWNER: Howard Wagon
 Holly Springs, Miss
 RFD
 (mailing address)

description of formations encountered	from	to
Surface Soil	0	25
Med. Brown Soil	25	43
White Clay	43	60
Blue Mud	60	140
Fine Gray & med white sand	140	178

WELL LOCATION:
 sec. 6 T. 5 N R. 1 E
 3 miles (distance) West of Little Comp (direction) (nearest town)

WELL PURPOSE: Home
 (home, irrigation, municipal, industrial)


- WELL COMPLETION DATA:
- (1) diameter (inches) 4
 - (2) total depth (feet) 178
 - (3) static water level (feet) 65 below top of ground.
 - (4) casing Plastic, 148 ft.
(material) (depth)
if telescope see back.
 - (5) screen 30 ft., 148
(length) (depth to top)
4 in., Plastic
(size) (material)
 - (6) pump 3/4, 10
(HP) (yield gpm)
Elec.
(type power)
 - (7) electric log No.
(yes or no)
 - (organization running log)
 - (8) how well bottom plugged Plastic Cap

DRILLERS REMARKS:

RECEIVED
 MAR 2 1976

If well telescopes please sketch and show depths.

GROUND LEVEL

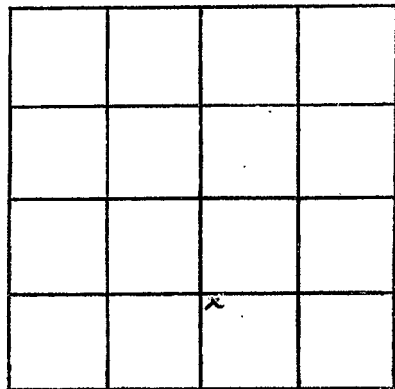

SECTION 6

Please indicate well location X.

ADDITIONAL INFORMATION

If more than one screen, show locations of each on sketch.