

MARSHALL
W. 2004

MISSISSIPPI
BOARD OF WATER COMMISSIONERS
416 North State Street
Jackson, Mississippi 39201

W

9/21/79
9-21-19
date well completed

WATER WELL DRILLERS LOG

J T Medlin
firm name

MARSHALL
county well located

LANDOWNER: See Wiggins
POTS CAMP
H.W. 78 West
(mailing address)

description of formations encountered	from	to
clay	0	12
sand	12	35
clay	35	250
sand	250	300
clay	300	785
rocky sand	785	865

WELL LOCATION:
sec. 6 T 5 N R 1 E
4 miles W of POTS CAMP
(distance) (direction) (nearest town)

WELL PURPOSE:
(home, irrigation, municipal, industrial)


- WELL COMPLETION DATA:
- (1) diameter (inches) 4
 - (2) total depth (feet) 865
 - (3) static water level (feet) 75 below top of ground
 - (4) casing ~~steel~~ 370 (material) (depth) Black Steel Pipe (size) if telescope see back.
 - (5) screen (length) (depth to top) (size) (material)
 - (6) pump 5 (HP) 8 (yield gpm) E (type power)
 - (7) electric log (yes or no) (organization running log)
 - (8) how well bottom plugged Open

DRILLERS REMARKS:

NA
10' ju

If well telescopes please sketch and show depths.

GROUND LEVEL

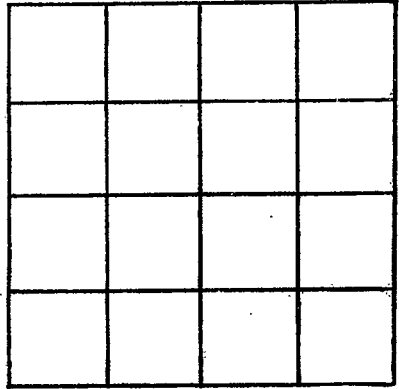

SECTION _____

Please indicate well location X.

ADDITIONAL INFORMATION

If more than one screen, show locations of each on sketch.