

Marshall  
 U 2005  
 8-14-80

MISSISSIPPI  
 BOARD OF WATER COMMISSIONERS  
 416 North State Street  
 Jackson, Mississippi 39201

WATER WELL DRILLERS LOG

Aug 14 1980  
 date well completed

J J Madlin  
 firm name

Marshall  
 county well located

LANDOWNER: Billy D Swigg  
 Pett Camp  
 HW 78 West  
 (mailing address)

| description of formations encountered | from | to  |
|---------------------------------------|------|-----|
|                                       | clay | 0   |
| rock & sand                           | 720  | 820 |

WELL LOCATION:  
 sec. 21 T. 5 N. R. 1 E  
 1 miles S of PETT CAMP  
 (distance) (direction) (nearest town)

WELL PURPOSE: FIRE STOCK  
 (home, irrigation, municipal, industrial)

- WELL COMPLETION DATA:
- (1) diameter (inches) 4
  - (2) total depth (feet) 820
  - (3) static water level (feet) 4 below top of ground.
  - (4) casing P 380 (material) (depth)
  - (size) if telescope see back.
  - (5) screen 100 760 (length) (depth to top)
  - (size) 2 (material)
  - (6) pump 12 (HP) (yield gpm)
  - (type power) e
  - (7) electric log (yes or no)

(organization running log)

(8) how well bottom plugged

DRILLERS REMARKS:


DEPT. OF NATURAL RESOURCES  
 BUREAU OF LAND & WATER RESOURCES

AUG 25 1980

RECEIVED

If well telescopes please sketch and show depths.

GROUND LEVEL

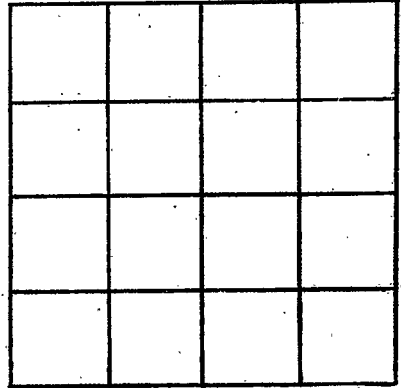

SECTION \_\_\_\_\_

Please indicate well location X.

ADDITIONAL INFORMATION

If more than one screen,  
show locations of each on sketch.