

MARSHALL
 U-2006
 5/20/81

MISSISSIPPI
 BOARD OF WATER COMMISSIONERS
 416 North State Street
 Jackson, Mississippi 39201

WATER WELL DRILLERS LOG

5-20 1981 J. T. Medlin MARSHALL
 date well completed firm name county well located

LANDOWNER: Donald Ash
 Holly Springs, Ms.
 38635
 (mailing address)

description of formations encountered	from	to
Sand	0	300
Mixed Clay and Rock	300	450
Blue Clay	450	670
Mixed Clay	670	870
Sand and Shell	870	960

WELL LOCATION:
 sec. 31 T. 5 N. R. 1 E
 4 miles W of Port Camp
 (distance) (direction) (nearest town)

WELL PURPOSE:
 (home, irrigation, municipal, industrial)


- WELL COMPLETION DATA:
- (1) diameter (inches) 4
 - (2) total depth (feet) 960
 - (3) static water level (feet) 70 below top of ground.
 - (4) casing PVC 510 (material) (depth)
 (size) if telescope see back.
 - (5) screen 0 (length) (depth to top)
 (size) (material)
 - (6) pump 1/2 12 (HP) (yield gpm)
 Elec. (type power)
 - (7) electric log (yes or no)
 (organization running log)
 - (8) how well bottom plugged

DRILLERS REMARKS:

DEPT. OF NATURAL RESOURCES
 BUREAU OF LAND & WATER RESOURCES
 RECEIVED
 MAY 29 1981

If well telescopes please sketch and show depths.

GROUND LEVEL

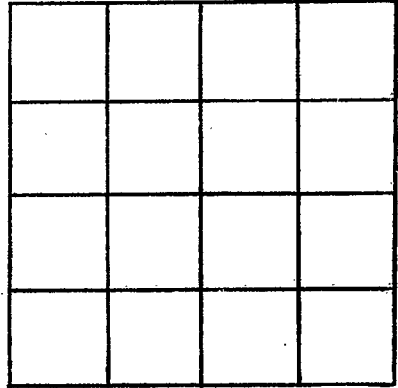

SECTION _____

Please indicate well location X.

ADDITIONAL INFORMATION

If more than one screen,
show locations of each on sketch.