

MISSISSIPPI DEPARTMENT OF NATURAL RESOURCES

Bureau of Land and Water Resources

Southport Mall

P.O. Box 10631

Jackson, Mississippi 39209

WATER WELL DRILLERS LOG

Marshall
U 2012

8.3.86
date well completed

19 Medlin Well Drilling Marshall
firm name county well located

LANDOWNER:	description of formations encountered	from	to
<u>Walter Hester</u> <u>Potts Comp, MS.</u> (mailing address)			
WELL LOCATION:	<u>Rock & Blue Clay</u>	<u>280</u>	<u>450</u>
sec. <u>5</u> T. <u>5</u> N. R. <u>1</u> E. <u>W</u>	<u>Rock & Sandstone</u>	<u>450</u>	<u>650</u>
<u>4</u> miles <u>S</u> of <u>Potts Comp</u> (distance) (direction) (nearest town) <u>Highway 349</u>	<u>White clay - sand</u> <u>agriculture</u>	<u>650</u>	<u>780</u>
WELL PURPOSE: (home, irrigation, municipal, industrial)			
WELL COMPLETION DATA:			
(1) diameter (inches) <u>4"</u>			
(2) total depth (feet) <u>780 Approx.</u>			
(3) static water level (feet) <u>250</u> <u>below</u> above top of ground.			
(4) casing <u>PVC</u> <u>340</u> (material) (depth)			
_____ if telescope see back. (size)			
(5) screen _____ (length) (depth to top)			
(size) _____ (material)			
(6) pump <u>1</u> <u>15</u> (HP) (yield gpm)			
<u>Close</u> (type power)			
(7) electric log _____ (yes or no)			
_____ (organization running log)			
(8) how well bottom plugged _____			
DRILLERS REMARKS:			


RECEIVED

DEC 15 1986

Department of Natural Resources
Bureau of Land & Water Resources

If well telescopes please
sketch and show depths.

GROUND LEVEL

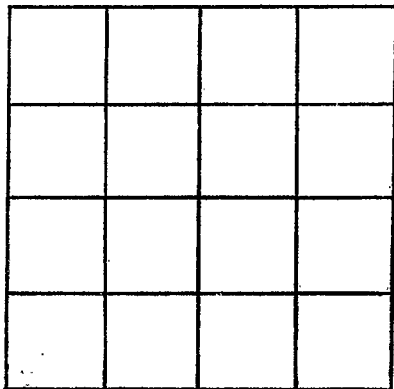

SECTION _____

Please indicate well location X.

ADDITIONAL INFORMATION

If more than one screen,
show locations of each on sketch.