

Marshall
7/1/80
8-14-80

MISSISSIPPI
BOARD OF WATER COMMISSIONERS
416 North State Street
Jackson, Mississippi 39201

WATER WELL DRILLERS LOG

Aug 14 1980 JT Medlin Marshall
date well completed firm name county well located

LANDOWNER: Rheola Smith
POTT CAMP
HW 349 POTT CAMP
(mailing address)

description of formations encountered	from	to
Clay	0	20
sand & Clay	20	360
Clay	360	470
rock & sand	470	860

WELL LOCATION:
sec. 32 T 5 N R 1 E
3 miles EN of Bethel
(distance) (direction) (nearest town)

WELL PURPOSE:
(home, irrigation, municipal, industrial)

- WELL COMPLETION DATA:
- (1) diameter (inches) 4
 - (2) total depth (feet) 860
 - (3) static water level (feet) 135 below top of ground.
 - (4) casing P 400 (material) (depth)
 - 2 (size) if telescope see back.
 - (5) screen 100 860 (length) (depth to top)
 - 2 (size) P (material)
 - (6) pump 3/4 12 (HP) (yield gpm)
 - E (type power)
 - (7) electric log (yes or no)
 - (organization running log)
 - (8) how well bottom plugged Cap

DRILLERS REMARKS:

DEPT. OF NATURAL RESOURCES
BUREAU OF LAND & WATER RESOURCES

AUG 25 1980


RECEIVED

If well telescopes please sketch and show depths.

GROUND LEVEL

7" casing
400 ft

2" diameter
2" pipe
2100
24380

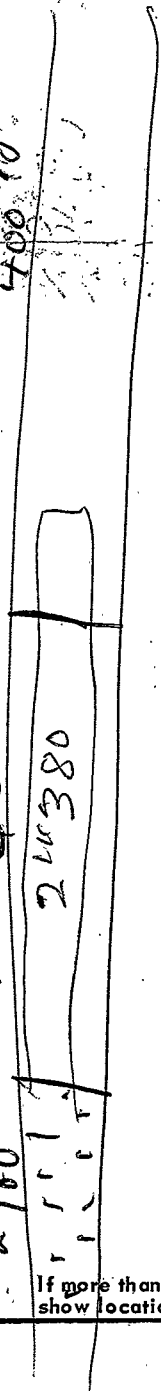

SECTION _____

Please indicate well location X.

ADDITIONAL INFORMATION

If more than one screen, show locations of each on sketch.