

MARSHALL

V 2

10-23-70

MISSISSIPPI BOARD OF WATER COMMISSIONERS 416 North State Street Jackson, Mississippi 39201

CODED

WATER WELL DRILLERS LOG

Oct 23 19 70 R. L. Carpenter Marshall date well completed firm name county well located

LANDOWNER: Joe Snipes Laws Hill, Miss.

RFD (mailing address)

WELL LOCATION:

sec. 11 T 6 N R 4 E 1 1/2 miles S of Laws Hill (distance) (direction) (nearest town)

WELL PURPOSE: (home, irrigation, municipal, industrial)

WELL COMPLETION DATA:

- (1) diameter (inches) 4
(2) total depth (feet) 225 ft
(3) static water level (feet) 135 below top of ground.
(4) casing Plastic, 219 ft. (material) (depth)

(size) if telescope see back.

- (5) screen 6 ft, 219 ft. (length) (depth to top) 4 in. Plastic & gravel (size) (material)

- (6) pump 3/4 10 (HP) (yield gpm)

Electric (type power)

- (7) electric log No (yes or no)

(organization running log)

- (8) how well bottom plugged Plastic Pleg

description of formations encountered

from to

Table with 3 columns: description of formations encountered, from, to. Rows include: Surface soil (0-20), Med. white sand (20-36), white clay (36-51), Med white sand (51-170), Coarse white sand (170-225).

CODED


DEC 7 1970

DRILLERS REMARKS:

MISS. BD. OF WATER COMM.

If well telescopes please sketch and show depths.

GROUND LEVEL

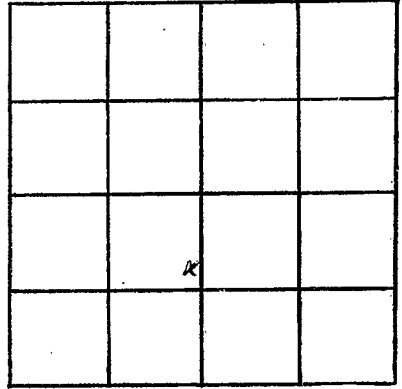

SECTION 16

Please indicate well location X.

ADDITIONAL INFORMATION

If more than one screen, show locations of each on sketch.