

MARSHALL
V 3
5-4-71

MISSISSIPPI
BOARD OF WATER COMMISSIONERS
416 North State Street
Jackson, Mississippi 39201

CODED

WATER WELL DRILLERS LOG

5-4 19 71 ^{Dean's Hart} Burgess well Co. Marshall
date well completed firm name county well located

LANDOWNER:	description of formations encountered	from	to
<u>Selney Show</u> <u>Waterford Miss</u> (mailing address)			
WELL LOCATION:	<u>sand</u>	<u>20</u>	<u>30</u>
sec. <u>12</u> T. <u>6</u> N. R. <u>4</u> E.	<u>clay</u>	<u>30</u>	<u>80</u>
<u>20</u> miles <u>South</u> of <u>Hacksburg</u>	<u>sand</u>	<u>80</u>	<u>210</u>
(distance) (direction) (nearest town)			
WELL PURPOSE: <u>Drinking</u> (home, irrigation, municipal, industrial)			
WELL COMPLETION DATA:			
(1) diameter (inches) <u>4"</u>			
(2) total depth (feet) <u>210 feet</u>			
(3) static water level (feet) <u>110</u> ^{below} <u>ground</u> _{above}			
(4) casing <u>pvc</u> <u>210 feet</u> (material) (depth)			
(size) if telescope see back.			
(5) screen <u>6 ft</u> <u>204 feet</u> (length) (depth to top)			
<u>4"</u> <u>gravel wall</u> (size) (material)			
(6) pump <u>3/4</u> <u>10</u> (HP) (yield gpm)			
(type power)			
(7) electric log <u>elect.</u> (yes or no)			
(organization running log)			
(8) how well bottom plugged <u>4" cap</u>			
DRILLERS REMARKS:			


CODED

JUN 9 1971

MISS. BD. OF
WATER COMM.

If well telescopes please sketch and show depths.

GROUND LEVEL

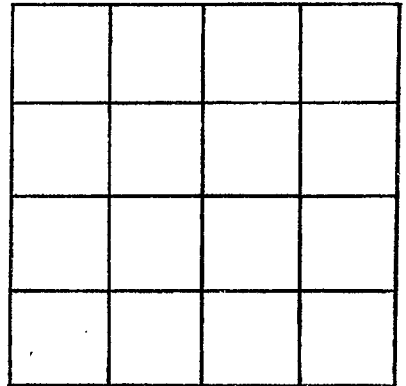

SECTION _____

Please indicate well location X.

ADDITIONAL INFORMATION

If more than one screen, show locations of each on sketch.