

MARSHALL
 V 4
 5-23-71

MISSISSIPPI
 BOARD OF WATER COMMISSIONERS
 416 North State Street
 Jackson, Mississippi 39201

CODED

WATER WELL DRILLERS LOG

5-23 1971 Dean Kent Surface wells Marshall
 date well completed firm name county well located

LANDOWNER:

William DeLoach
P.O. 2 Waterford miss
 (mailing address)

description of formations encountered

from to

Clay 0 30

Sand 30 50

Clay 50 55

sand 55 150

WELL LOCATION:

sec. 13 T. 6 N. R. 4 E
22 miles South of Half Springs
 (distance) (direction) (nearest town)

WELL PURPOSE: Rural
 (home, irrigation, municipal, industrial)

WELL COMPLETION DATA:

- (1) diameter (inches) 4"
- (2) total depth (feet) 150 feet
- (3) static water level (feet) 120 ^{below} / 30 ^{above} top of ground.
- (4) casing PVC (material), 150 feet (depth)

CODED

- (size) if telescope see back.
- (5) screen 6 ft (length), 144 feet (depth to top)
- 4" (size), gravel well (material)
- (6) pump 3/4 (HP), 10 (yield gpm)

- (type power)
- (7) electric log elect (yes or no)

(organization running log)

- (8) how well bottom plugged 4" cap


JUN 9 1971

MISS. BD. OF
 WATER COMM

DRILLERS REMARKS:

If well telescopes please sketch and show depths.

GROUND LEVEL

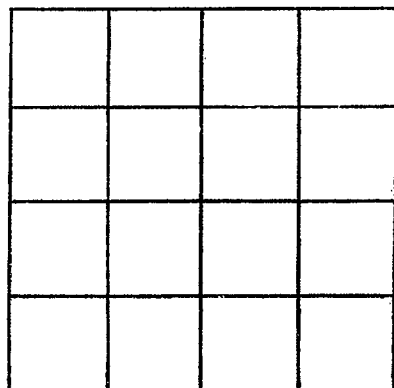

SECTION _____

Please indicate well location X.

ADDITIONAL INFORMATION

If more than one screen,
show locations of each on sketch.