

MARSHALL
V 5
5-28-71

MISSISSIPPI
 BOARD OF WATER COMMISSIONERS
 416 North State Street
 Jackson, Mississippi 39201

CODED

WATER WELL DRILLERS LOG

5-28 1971 Dean & Ken bumper wells Marshall
 date well completed firm name county well located

LANDOWNER:

George Harden
Rt. 2 Waterford miss
 (mailing address)

description of formations encountered

	from	to
<u>clay</u>	<u>0</u>	<u>30</u>
<u>sand</u>	<u>30</u>	<u>60</u>
<u>clay</u>	<u>60</u>	<u>70</u>
<u>sand</u>	<u>70</u>	<u>160</u>

WELL LOCATION:

sec. 12 T. 6 N. R. 4 E.
 (S) (W)
2.1 miles South of Waterford
 (distance) (direction) (nearest town)

WELL PURPOSE:

Drillers
 (home, irrigation, municipal, industrial)

WELL COMPLETION DATA:

- diameter (inches) 4"
- total depth (feet) 160 feet
- static water level (feet) 130 below above top of ground.
- casing PVC, 160 feet
 (material) (depth)
 (size) if telescope see back.
- screen 6 ft, 154 feet
 (length) (depth to top)
4" gravel coat
 (size) (material)
- pump 3/4 10
 (HP) (yield gpm)

CODED

- (type power)
- electric log elect.
 (yes or no)
- (organization running log)

- how well bottom plugged 4' cap.


JUN 9 1971

MISS. BD. OF
 WATER COMMISSIONERS

DRILLERS REMARKS:

If well telescopes please sketch and show depths.

GROUND LEVEL

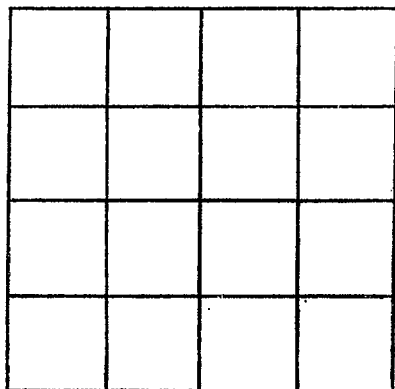

SECTION _____

Please indicate well location X.

ADDITIONAL INFORMATION

If more than one screen,
show locations of each on sketch.