

Marshall  
V-6  
6-18-71

MISSISSIPPI  
BOARD OF WATER COMMISSIONERS  
416 North State Street  
Jackson, Mississippi 39201

DUPLICATED  
WATER WELL DRILLERS LOG

June 18 1971 R. L. Copester Marshall  
date well completed firm name county well located

LANDOWNER: Mrs. L. C. McClinton  
Laws Hill, Miss  
R. F. D.  
(mailing address)

description of formations encountered	from	to
Surface Soil	0	10
Med. Brown sand	10	42
Med. white sand	42	155
white clay	155	177
Med. white sand	177	195
white clay	195	197
Med white sand	197	293
Med coarse white sand	293	335

WELL LOCATION:  
sec 12 T 6 N R 4 E  
Laws Hill  
(distance) miles (direction) of (nearest town)

WELL PURPOSE: None  
(home, irrigation, municipal, industrial)

- WELL COMPLETION DATA:
- (1) diameter (inches) 4
  - (2) total depth (feet) 335
  - (3) static water level (feet) 265 below top of ground.
  - (4) casing Plastic, 323 ft (material) (depth)
  - (size) If telescope see back.
  - (5) screen 12, 323 ft (length) (depth to top)  
4 in. Plastic Band (size) (material)
  - (6) pump 3/4, 10 (HP) (yield gpm)  
9 hp (type power)
  - (7) electric log No (yes or no)


(organization running log)  
(8) how well bottom plugged Plastic clay

DRILLERS REMARKS:

SEP 7 1971  
MISS. BD. OF WATER COMM.

If well telescopes please sketch and show depths.

GROUND LEVEL

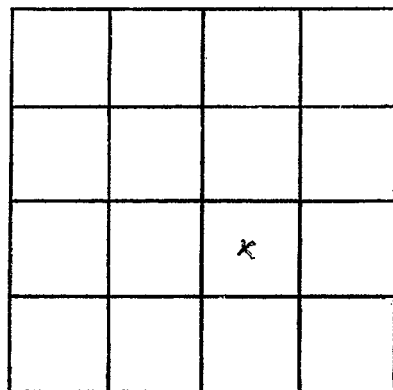

SECTION 12

Please indicate well location X.

ADDITIONAL INFORMATION

If more than one screen, show locations of each on sketch.