

Marshall
 V8
 6-68

MISSISSIPPI
 BOARD OF WATER COMMISSIONERS
 416 North State Street
 Jackson, Mississippi 39201

WATER WELL DRILLERS LOG **CODED**

June 16 1968 Bumpas Well Co. Marshall
 date well completed firm name county well located

LANDOWNER: James Malone
 waterford, Miss.

description of formations encountered	from	to
	Red Clay Sand	0 30


(mailing address)

WELL LOCATION:
 sec. 12 T 6 N R 4 E
 (S) (W)
 1 miles W of Sours Hill
 (distance) (direction) (nearest town)

WELL PURPOSE: Dwelling House
 (home, irrigation, municipal, industrial)

- WELL COMPLETION DATA:
- (1) diameter (inches) 4"
 - (2) total depth (feet) 270 ft.
 - (3) static water level (feet) 180 (below/above top of ground)
 - (4) casing Plastic, 264 ft.
 (material) (depth)
 No (size) if telescope see back.
 - (5) screen 6 ft., 264 ft.
 (length) (depth to top)
 008 (size), Grove Wall (material)
 - (6) pump 3/4 HP, 10 gal
 (HP) (yield gpm)
 Elect. (type power)
 - (7) electric log (yes or no)
 (organization running log)
 - (8) how well bottom plugged Plastic Cap


CODED

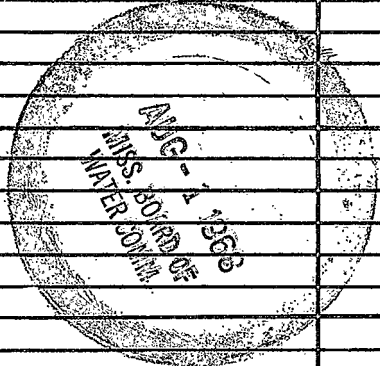

DRILLERS REMARKS:

If well telescopes please
sketch and show depths.

GROUND LEVEL

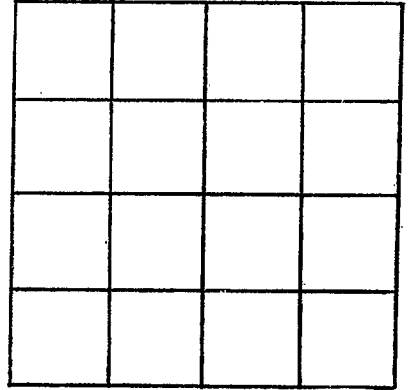

SECTION _____

Please indicate well location X.

ADDITIONAL INFORMATION

If more than one screen,
show locations of each on sketch.