

Marshall
V9
7-68

MISSISSIPPI
BOARD OF WATER COMMISSIONERS
416 North State Street
Jackson, Mississippi 39201

WATER WELL DRILLERS LOG **CODED**

July 6 1968 Pomposwell Co. Marshall
date well completed firm name county well located

LANDOWNER: J.C. Jugar
Waterford, Miss.

description of fomations encountered	from	to
	<u>Red Clay</u>	<u>0</u>
<u>Sand & white clay mixed</u>	<u>30</u>	<u>270</u>


(mailing address)

WELL LOCATION:
sec. 11 T. 6 N R. 4 E
3 W
1 miles N-W of Lewis Hill
(distance) (direction) (nearest town)

WELL PURPOSE: Dwelling House
(home, irrigation, municipal, industrial)

- WELL COMPLETION DATA:
- (1) diameter (inches) 4"
 - (2) total depth (feet) 270 ft.
 - (3) static water level (feet) 230 below top of ground.
 - (4) casing plastic, 264 ft.
(material) (depth)
 - no if telescope see back.
(size)
 - (5) screen 6 ft., 264 ft.
(length) (depth to top)
 - 60 8, gravel wall
(size) (material)
 - (6) pump 3/4 10 gal
(HP) (yield gpm)
 - Elec.
(type power)
 - (7) electric log (yes or no)
 - (organization running log)
 - (8) how well bottom plugged plastic plug


CODED

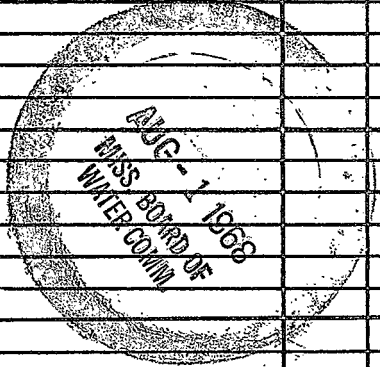

DRILLERS REMARKS:

If well telescopes please sketch and show depths.

GROUND LEVEL

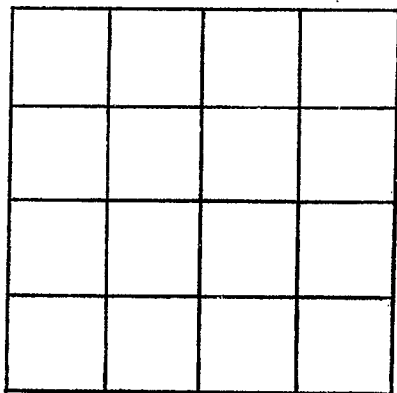

SECTION _____

Please indicate well location X.

ADDITIONAL INFORMATION

If more than one screen,
show locations of each on sketch.