

Marshall
 V 10
 8-22-68

MISSISSIPPI
 BOARD OF WATER COMMISSIONERS
 416 North State Street
 Jackson, Mississippi 39201

CODED

WATER WELL DRILLERS LOG

Aug. 27 1968 Bumpas Well Co Marshall
 date well completed name county well located

LANDOWNER: M. D. Bumpas
Laws Hill, Miss

description of formations encountered	from	to
<u>Clay</u>	<u>0</u>	<u>80</u>
<u>Sand</u>	<u>80</u>	<u>150</u>


(mailing address)

WELL LOCATION:
 sec. 18 T. 6 N. R. 3 E
2 1/2 miles South of Laws Hill
 (distance) (direction) (nearest town)

WELL PURPOSE:
 (home, irrigation, municipal, industrial)

- WELL COMPLETION DATA:
- (1) diameter (inches) 4"
 - (2) total depth (feet) 150
 - (3) static water level (feet) 130 ^{below} top of ground.
 - (4) casing plastic 143
 (material) (depth)
 - 4" if telescope see back.
 (size)
 - (5) screen 143
 (length) (depth to top)
 - 6" gravel wall
 (size) (material)
 - (6) pump 3/4 HP 10
 (HP) (yield gpm)
 - Elec
 (type power)
 - (7) electric log _____
 (yes or no)
 - _____ (organization running log)
 - (8) how well bottom plugged 4" cap


CODED

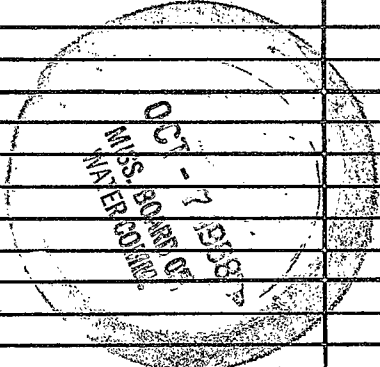

DRILLERS REMARKS:

If well telescopes please sketch and show depths.

GROUND LEVEL

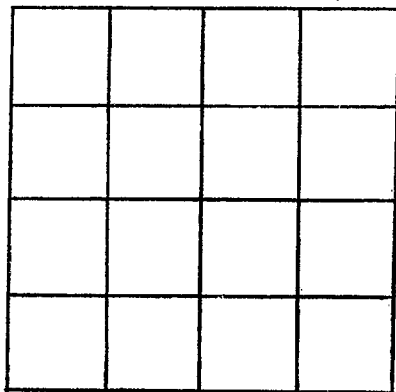

SECTION _____

Please indicate well location X.

ADDITIONAL INFORMATION

If more than one screen, show locations of each on sketch.