

MARSHALL
V13
4-15-72

MISSISSIPPI
 BOARD OF WATER COMMISSIONERS
 416 North State Street
 Jackson, Mississippi 39201

WATER WELL DRILLERS LOG

CODED

4-15 1972 G. & H. Well Co MARSHAL
 date well completed firm name county well located

LANDOWNER: E. J. Sterlin
RT. 2 BOX 94A
Waterford Miss.
 (mailing address)
 WELL LOCATION:
 sec 13 T 6 N R 4 E
6 miles EAST of Waterford
 (distance) (direction) (nearest town)

description of formations encountered	from	to
Red SAND	0	15
White CLAY	15	75
White SANDY CLAY	75	105
White SAND	105	195

WELL PURPOSE:
 (home, irrigation, municipal, industrial)

- WELL COMPLETION DATA:
- (1) diameter (inches) 2"
 - (2) total depth (feet) 195
 - (3) static water level (feet) 144 below above top of ground.
 - (4) casing PLASTIC, 185
 (material) (depth)
0 If telescope see back.
 (size)
 - (5) screen 10", 185"
 (length) (depth to top)
4", SLATED PLASTIC
 (size) (material)
 - (6) pump 3/4 10
 (HP) (yield gpm)
220 EIBC
 (type power)
 - (7) electric log NO
 (yes or no)
 (organization running log)
 - (8) how well bottom plugged CAP

CODED


MAY 1 1972

DRILLERS REMARKS:

MISS. BD. OF
 WATER COMM.

If well telescopes please sketch and show depths.

GROUND LEVEL

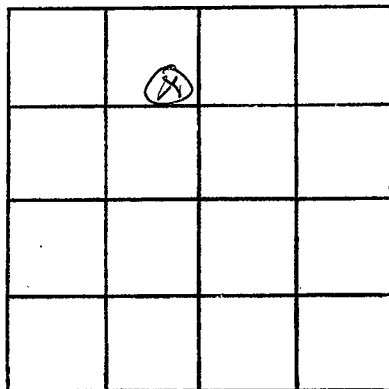

SECTION _____

Please indicate well location X.

ADDITIONAL INFORMATION

If more than one screen,
show locations of each on sketch.