

**MARSHALL**  
 V 15  
 7-24-72

MISSISSIPPI  
 BOARD OF WATER COMMISSIONERS  
 416 North State Street  
 Jackson, Mississippi 39201

**CODED**

**WATER WELL DRILLERS LOG**

7-24-72 date well completed      Bob Smith firm name      Marshall county well located


LANDOWNER:	description of formations encountered	from	to
J. H. Carlson Wygatt, Miss. (mailing address)			
WELL LOCATION:	white sand	15	220
sec. 13 T. 6 N. R. 4 E. 2 miles South of Law Hill (distance) (direction) (nearest town)			
WELL PURPOSE: (home, irrigation, municipal, industrial)			
WELL COMPLETION DATA:			
(1) diameter (inches) 4			
(2) total depth (feet) 220			
(3) static water level (feet) 175 below top of ground.			
(4) casing Plastic 220 (material) (depth)			
(size) if telescope see back.			
(5) screen 20 200 (length) (depth to top)			
4 Plastic (size) (material)			
(6) pump 1/2 10 (HP) (yield gpm)			
Electric (type power)			
(7) electric log no (yes or no)			
(organization running log)			
(8) how well bottom plugged plugged			
DRILLERS REMARKS:			

**CODED**

FILE 600 1000  
 FILE 600 1000

If well telescopes please sketch and show depths.

GROUND LEVEL

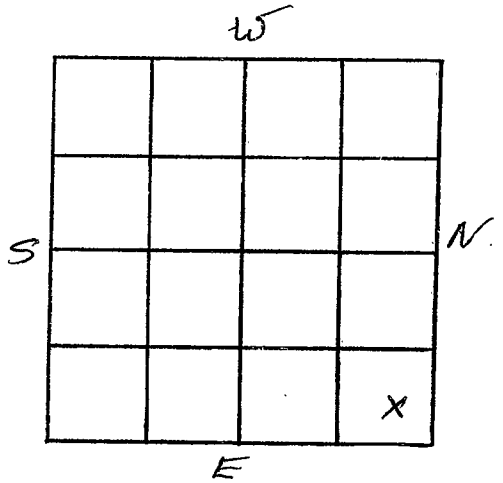

SECTION 13

Please indicate well location X.

ADDITIONAL INFORMATION

If more than one screen,  
show locations of each on sketch.