

MARSHALL

V17

10-10-73

MISSISSIPPI
 BOARD OF WATER COMMISSIONERS
 416 North State Street
 Jackson, Mississippi 39201 **CODED**

WATER WELL DRILLERS LOG

10-10 date well completed

1973 Dean & Kent Burges well firm name

Marshall county well located

LANDOWNER:

Milton Howell
Pt. 2, Waterford, Miss.
(mailing address)

description of formations encountered

from to

clay

0 30

sand

30 140

clay

140 145

sand

145 210

WELL LOCATION:

sec. 14 T 4 N R 4 E
3 miles South of South Hill
(distance) (direction) (nearest town)

WELL PURPOSE: Dwelling
(home, irrigation, municipal, industrial)

WELL COMPLETION DATA:

- (1) diameter (inches) 4"
- (2) total depth (feet) 210 feet
- (3) static water level (feet) 130 below top of ground.
- (4) casing PVC, 210 (material) (depth)

CODED

(size) If telescope see back.

- (5) screen 7ft., 203 (length) (depth to top)
- 15" gravel wall (size) (material)

- (6) pump 3/4 (HP), 14 (yield gpm)

(type power)

- (7) electric log Elect. (yes or no)

(organization running log)


- (8) how well bottom plugged 4" cap.

DRILLERS REMARKS:

MAY 9 1973
MISS. Bd. OF WATER POWER

If well telescopes please sketch and show depths.

GROUND LEVEL

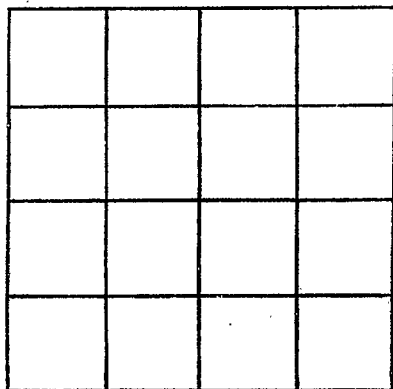

SECTION _____

Please indicate well location X.

ADDITIONAL INFORMATION

If more than one screen, show locations of each on sketch.