

Marshall
 V 21
 4-20-75

MISSISSIPPI
 BOARD OF WATER COMMISSIONERS
 416 North State Street
 Jackson, Mississippi 39201

CODED

WATER WELL DRILLERS LOG

W. A. Mason
 Water Well Contractor

Marshall

4-20-75
 date well completed

W. A. Mason
 firm name

Marshall
 county well located

LANDOWNER:

Bill Patterson

description of formations encountered

Clay Soil

from

to

00

10

Memphis Tenn
 (mailing address)

Red sand

10

35

WELL LOCATION:

sec 13 T 6 N R 4 E 15F
 2 miles SW of Jones Hill
 (distance) (direction) (nearest town)

white sand

35

170

WELL PURPOSE:

Home
 (home, irrigation, municipal, industrial)

WELL COMPLETION DATA:

- (1) diameter (inches) 16"
- (2) total depth (feet) 190'
- (3) static water level (feet) 170' below top of ground
- (4) casing Plastic 177' (material) (depth)
 4" (size) If telescope see back.
- (5) screen 13' 177' (length) (depth to top)
 2" Plastic (size) (material)
- (6) pump 3/4 HP 7 (yield gpm)
 electric (type power)
- (7) electric log No (yes or no)

(organization running log)

(8) how well bottom plugged

Cap on bottom


DRILLERS REMARKS:

RECEIVED

APR 01 1975

If well telescopes please sketch and show depths.

GROUND LEVEL

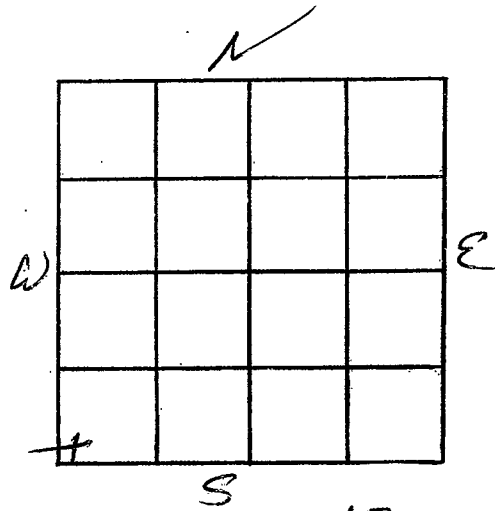

SECTION 13

Please indicate well location X.

ADDITIONAL INFORMATION

If more than one screen, show locations of each on sketch.