

Marshall
 V 22
 7-31-75

MISSISSIPPI
 BOARD OF WATER COMMISSIONERS
 416 North State Street
 Jackson, Mississippi 39201

WATER WELL DRILLERS LOG

CODED

July 31 1975 Dean Kent Burpwell Marshall
 date well completed firm name county well located

LANDOWNER:
H.C. Edlin
Los Hill
 (mailing address)

description of formations encountered	from	to
clay	0	20
sand	20	85
clay	85	90
sand	90	140
clay	140	160
sand	160	230

WELL LOCATION: ^{15F}
 sec. 14 T 6 N R 4 E (Saw Mill)
3 miles S.W. of Los Hill
 (distance) (direction) (nearest town)

WELL PURPOSE: Drinking
 (home, irrigation, municipal, industrial)

WELL COMPLETION DATA:

(1) diameter (inches) 4"

(2) total depth (feet) 230 feet

(3) static water level (feet) 140 below above top of ground.

(4) casing pvc, 230 feet
 (material) (depth)
 (size) if telescope see back.

(5) screen 7ft., 223 feet
 (length) (depth to top)
4", gravel wall
 (size) (material)

(6) pump 3/4, 14
 (HP) (yield/gpm)
 (type power)

(7) electric log Elect.
 (yes or no)
 (organization running log)

(8) how well bottom plugged 4" cpi

CODED


REGISTERED
 REGISTERED
 AUG 6 1975

DRILLERS REMARKS:

MISS. BD. OF WATER COMMISSIONERS

If well telescopes please sketch and show depths.

GROUND LEVEL

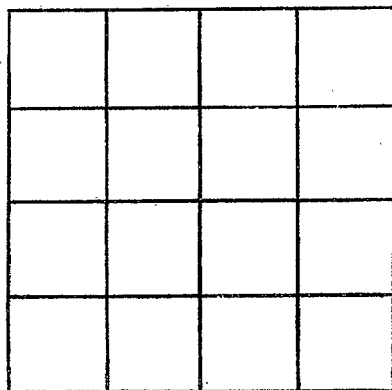

SECTION _____

Please indicate well location X.

ADDITIONAL INFORMATION

If more than one screen,
show locations of each on sketch.