

MARSHALL
V 2000
7-9-76

MISSISSIPPI
 BOARD OF WATER COMMISSIONERS
 416 North State Street
 15F Jackson, Mississippi 39201

WATER WELL DRILLERS LOG

7-9-76 19 Bob Littlewood Marshall
 date well completed firm name county well located

LANDOWNER:	description of formations encountered	from	to
<u>Pete Brown</u>			
<u>Law Hill</u> (mailing address)	<u>top soil</u>	<u>0</u>	<u>5</u>
	<u>red clay</u>	<u>5</u>	<u>40</u>
	<u>sand & clay</u>	<u>40</u>	<u>190</u>
	<u>sand</u>	<u>190</u>	<u>250</u>

WELL LOCATION:
 sec. 16 T 6 N R 4 E
 (distance) miles (direction) of Law Hill
 (nearest town)

WELL PURPOSE:
 (home, irrigation, municipal, industrial)

- WELL COMPLETION DATA:
- (1) diameter (inches) 4"
 - (2) total depth (feet) 250
 - (3) static water level (feet) 190 below top of ground.
 - (4) casing plastic, 250
(material), (depth)
(size) if telescope see back.
 - (5) screen 20, 230
(length), (depth to top)
4, plastic
(size), (material)
 - (6) pump 1/2, 10
(HP), (yield gpm)
E lee
(type power)
 - (7) electric log (yes or no)
 - (8) how well bottom plugged


DRILLERS REMARKS:

RECEIVED
 SEP 20 1976

MISS. BD. OF WATER COMM.

If well telescopes please sketch and show depths.

GROUND LEVEL

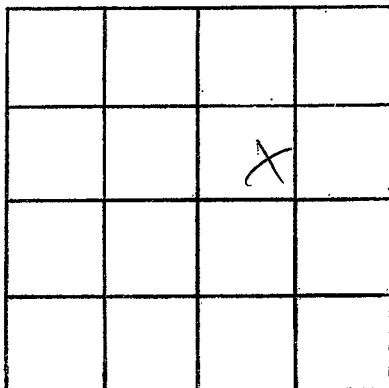

SECTION _____

Please indicate well location X.

ADDITIONAL INFORMATION

If more than one screen, show locations of each on sketch.