

MARSHALL

V 2003

8-8-76

MISSISSIPPI BOARD OF WATER COMMISSIONERS  
416 North State Street  
Jackson, Mississippi 39201

WATER WELL DRILLERS LOG

~~Aug 8~~ Aug 8 1976 R. L. Carpenter Marshall  
date well completed firm name county well located

LANDOWNER: Marshall County  
Laws Hill Community Center  
Laws Hill, Miss.  
(mailing address)

WELL LOCATION:  
sec. 12 T-6 N R-4 E  
In Laws Hill, Miss.  
(distance) miles (direction) of (nearest town)

WELL PURPOSE: Common Center  
(home, irrigation, municipal, industrial)

WELL COMPLETION DATA:  
(1) diameter (inches) 4  
(2) total depth (feet) 260  
(3) static water level (feet) 202 below above top of ground.  
(4) casing Plastic 254' (material) (depth)  
(size) If telescope see back.  
(5) screen 6' 254' (length) (depth to top)  
4" Plastic & Gravel (size) (material)  
(6) pump 3/4 10 (HP) (yield gpm)  
Elec. (type power)  
(7) electric log No (yes or no)  
(organization running log)  
(8) how well bottom plugged Plastic Cap

description of formations encountered	from	to
Surface Soil	0	28
Med. Red Sand	28	48
Med. White Sand	48	150
White Clay & White Fine Sand	150	185
Med. White Sand	185	226
White Coar. Sand	226	260


DRILLERS REMARKS:

RECEIVED  
MAY 12 1978

MISS. BD. OF WATER COMM

If well telescopes please sketch and show depths.

GROUND LEVEL

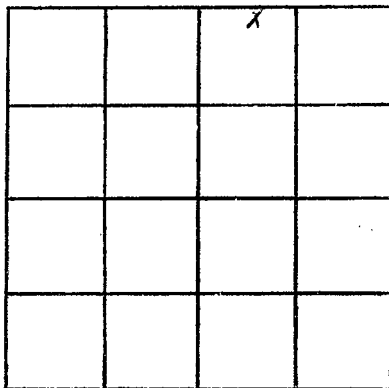

SECTION 12

Please indicate well location X.

ADDITIONAL INFORMATION

If more than one screen, show locations of each on sketch.