

MARSHALL
 V 2004
 8-15-76

MISSISSIPPI
 BOARD OF WATER COMMISSIONERS
 416 North State Street
 Jackson, Mississippi 39201

WATER WELL DRILLERS LOG

8-15-76 date well completed
 15F W. G. Mason, well driller firm name
 Marshall county well located

LANDOWNER:
 Jim Clewinger
 RED Holly Springs, Miss
 (mailing address)

description of formations encountered	from	to
Clay 1st	0	6
white sand	6	226

WELL LOCATION:
 sec. 10 T. 6 N. R. 4 E.
 6 1/2 miles South of Okolona
 (distance) (direction) (nearest town)

WELL PURPOSE: Home
 (home, irrigation, municipal, industrial)

WELL COMPLETION DATA:

- (1) diameter (inches) 4"
- (2) total depth (feet) 226'
- (3) static water level (feet) 175' below top of ground.
- (4) casing (material) (depth) Plastic 216'
- 4" if telescope see back. (size)
- (5) screen (length) (depth to top) 10' 216'
- 4" Plastic (size) (material)
- (6) pump (HP) (yield gpm) 1 12
- electric (type power)
- (7) electric log NO (yes or no)

(organization running log)

(8) how well bottom plugged cap


DRILLERS REMARKS:

RECEIVED
 JUL 7 - 1977

MISSISSIPPI BOARD OF WATER COMMISSIONERS

If well telescopes please sketch and show depths.

GROUND LEVEL

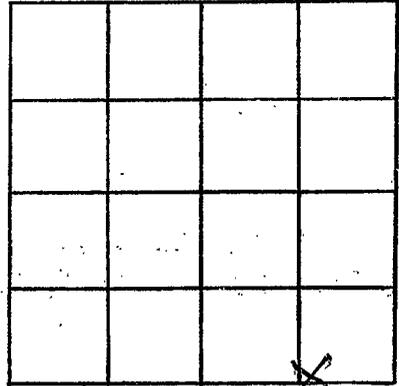

SECTION 10

Please indicate well location X.

ADDITIONAL INFORMATION

If more than one screen, show locations of each on sketch.