

MARSHALL

V 2005

8-18-76

MISSISSIPPI BOARD OF WATER COMMISSIONERS  
416 North State Street  
Jackson, Mississippi 39201

WATER WELL DRILLERS LOG

Aug 18 1976  
date well completed

R. L. Carpenter  
firm name

Marshall  
county well located

LANDOWNER: Arthur Hartley  
Laura Hill, Tris  
RFD  
(mailing address)

WELL LOCATION:  
sec. 14 T 6 N R 4 E  
4 miles S.W. of Laura Hill  
(distance) (direction) (nearest town)

WELL PURPOSE: Home  
(home, irrigation, municipal, industrial)

WELL COMPLETION DATA:  
(1) diameter (inches) 4  
(2) total depth (feet) 147  
(3) static water level (feet) 50 below above top of ground.  
(4) casing Plastic, 137'  
(material) (depth)  
(size) if telescope see back.  
(5) screen 18', 137'  
(length) (depth to top)  
4", Plastic  
(size) (material)  
(6) pump 1/2, 10  
(HP) (yield gpm)  
Elec.  
(type power)  
(7) electric log No.  
(yes or no)  
(organization running log)  
(8) how well bottom plugged Plastic cap


description of formations encountered	from	to
Surface Soil	0	15
White Coarse Sand	15	28
Red White Sand	28	67
White Clay	67	82
Red Clay		
White Fine Sand	82	118
White Coarse Sand	118	147

DRILLERS REMARKS:

RECEIVED  
MAY 12 1978  
MISS. BD. OF WATER COM. AM

If well telescopes please sketch and show depths.

GROUND LEVEL

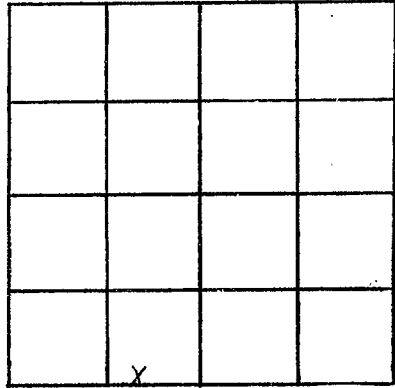

SECTION 14

Please indicate well location X.

ADDITIONAL INFORMATION

If more than one screen, show locations of each on sketch.