

Marshall
 V 2006
 8/31/76

MISSISSIPPI
 BOARD OF WATER COMMISSIONERS
 416 North State Street
 15F Jackson, Mississippi 39201

WATER WELL DRILLERS LOG

831 1976 date well completed
 High Well Co. firm name
 Marshall county well located

| LANDOWNER: <u>J. D. McPherson</u> | description of formations encountered | from | to |
|---|---------------------------------------|-----------|------------|
| <u>James Hill, Miss.</u> (mailing address) | | | |
| | <u>Red Sand</u> | <u>20</u> | <u>30</u> |
| | <u>White Sand</u> | <u>30</u> | <u>170</u> |

WELL LOCATION:
 sec. 13 T. 6 N. R. 4 E.
2 miles S of James Hill
 (distance) (direction) (nearest town)

WELL PURPOSE: Home
 (home, irrigation, municipal, industrial)

- WELL COMPLETION DATA:
- (1) diameter (inches) 4
 - (2) total depth (feet) 170
 - (3) static water level (feet) 120 below top of ground.
 - (4) casing PVC, 170,
 (material) (depth)
 (size) if telescope see back.
 - (5) screen 44, 166
 (length) (depth to top)
4" gravel
 (size) (material)
 - (6) pump 1/2, 10
 (HP) (yield gpm)
220V
 (type power)
 - (7) electric log NO
 (yes or no)
 (organization running log)
 - (8) how well bottom plugged Cap


DRILLERS REMARKS:

RECEIVED
 OCT - 5 1976

MISS. BD. OF WATER COMMISSIONERS

If well telescopes please sketch and show depths.

GROUND LEVEL

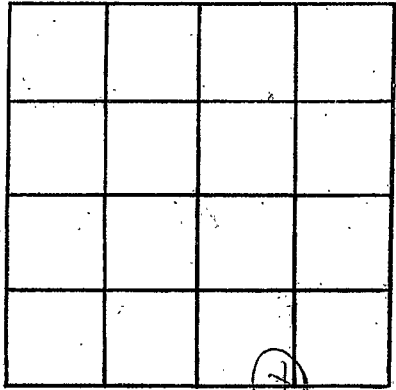

SECTION 13

Please indicate well location X.

ADDITIONAL INFORMATION

If more than one screen,
show locations of each on sketch.