

MARSHALL
 V 2007
 3/8/77

MISSISSIPPI
 BOARD OF WATER COMMISSIONERS
 416 North State Street
 15F Jackson, Mississippi 39201

WATER WELL DRILLERS LOG

3-8 1977 Dick Well Co Marshall
 date well completed firm name county well located

LANDOWNER: George Cook
Rt. 5
Holly Springs, Ms.
 (mailing address)

description of formations encountered	from	to
Red clay	0	40
Red Sand + clay	40	90
White clay	90	110
White Sand + clay	110	170
White Sand	170	235

WELL LOCATION:
 sec. 1 T. 6 N. R. 4 E.
1 miles N of Jays Mill
 (distance) (direction) (nearest town)

WELL PURPOSE: Home
 (home, irrigation, municipal, industrial)

WELL COMPLETION DATA:
 (1) diameter (inches) 4"
 (2) total depth (feet) 235
 (3) static water level (feet) 170 below top of ground.
 (4) casing PVC 235'
 (material) (depth)
 (size) if telescope see back.
 (5) screen 7ft 228ft
 (length) (depth to top)
4" Drum type
 (size) (material)
 (6) pump 3/4 10
 (HP) (yield gpm)
220V
 (type power)
 (7) electric log No.
 (yes or no)
 (organization running log)
 (8) how well bottom plugged Cap


RECEIVED
 APR 8 1977

DRILLERS REMARKS:

MISS. BD. OF W.

If well telescopes please sketch and show depths.

GROUND LEVEL

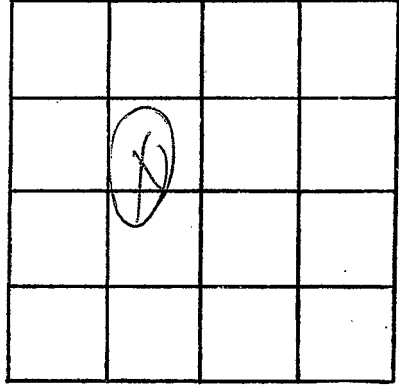

SECTION /

Please indicate well location X:

ADDITIONAL INFORMATION

If more than one screen,
show locations of each on sketch.