

MARSHALL  
V 2009  
3/10/79

MISSISSIPPI  
BOARD OF WATER COMMISSIONERS  
416 North State Street  
Jackson, Mississippi 39201

WATER WELL DRILLERS LOG

Mar. 10 1979 R. L. Carpenter Marshall  
date well completed firm name county well located

LANDOWNER: Marie Jasmine  
Louis Hill  
Miss.  
(mailing address)

description of formations encountered	from	to
<u>surface soil</u>	<u>0</u>	<u>21</u>
<u>med Red Sand</u>	<u>21</u>	<u>60</u>
<u>med white sand</u>	<u>60</u>	<u>130</u>
<u>white clay</u>	<u>130</u>	<u>168</u>
<u>med white sand</u>	<u>168</u>	<u>179</u>
<u>white coarse sand</u>	<u>179</u>	<u>203</u>

WELL LOCATION:  
sec. 1 T. 6 N. R. 4 E  
S. W.  
3/4 miles North of Louis Hill  
(distance) (direction) (nearest town)

WELL PURPOSE: None  
(home, irrigation, municipal, industrial)

WELL COMPLETION DATA:  
(1) diameter (inches) 4  
(2) total depth (feet) 203  
(3) static water level (feet) 165 below above top of ground.  
(4) casing Plastic 193'  
(material) (depth)  
(size) if telescope see back.  
(5) screen 10' 193'  
(length) (depth to top)  
4" Plastic  
(size) (material)  
(6) pump 3/4 10  
(HP) (yield gpm)  
Edco  
(type power)  
(7) electric log No  
(yes or no)  
(organization running log)


(8) how well bottom plugged Plastic Cap  
DRILLERS REMARKS:

DEPT. OF NATURAL RESOURCES  
BUREAU OF LAND & WATER RESOURCES

MAY 18 1981  
RECEIVED

If well telescopes please sketch and show depths.

GROUND LEVEL

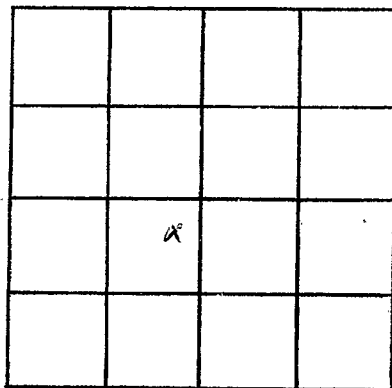

SECTION 1

Please indicate well location X.

ADDITIONAL INFORMATION

Lined area for additional information.

If more than one screen, show locations of each on sketch.