

MISSISSIPPI DEPARTMENT OF NATURAL RESOURCES

Bureau of Land and Water Resources

Southport Mall

P.O. Box 10631

Jackson, Mississippi 39209

WATER WELL DRILLERS LOG

MARSHALL  
V 2010  
12-16-80

12-16 1980 High Well Co. Marshall  
date well completed firm name county well located

LANDOWNER: Johnny Chambers  
3085 Signal  
Memphis, Tenn.  
(mailing address)

description of formations encountered	from	to
<u>Red Clay</u>	<u>0</u>	<u>10</u>
<u>Clay + sand</u>	<u>10</u>	<u>65</u>

WELL LOCATION:  
sec. W 6 N 4 E  
3 miles SW of Louis Hill  
(distance) (direction) (nearest town)

<u>Red Sand</u>	<u>65</u>	<u>125</u>
<u>White Sand</u>	<u>125</u>	<u>153</u>

WELL PURPOSE: farm  
(home, irrigation, municipal, industrial)

WELL COMPLETION DATA:  
(1) diameter (inches) 4  
(2) total depth (feet) 155  
(3) static water level (feet) 80 below above top of ground.  
(4) casing PVC 155  
(material) (depth)  
(size) if telescope see back.  
(5) screen 12 143  
(length) (depth to top)  
02 gravel type  
(size) (material)  
(6) pump 1/2 10  
(HP) (yield gpm)  
220V  
(type power)  
(7) electric log No  
(yes or no)  
(organization running log)  
(8) how well bottom plugged Cap

DRILLERS REMARKS:


DEPT. OF NATURAL RESOURCES  
BUREAU OF LAND & WATER RESOURCES

JAN 12 1981

RECEIVED

If well telescopes please sketch and show depths.

GROUND LEVEL

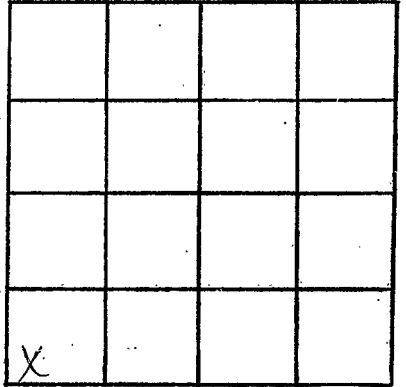

SECTION 14

Please indicate well location X.

ADDITIONAL INFORMATION

If more than one screen, show locations of each on sketch.