

MARSHALL  
V 2011  
10/13/80

MISSISSIPPI  
 BOARD OF WATER COMMISSIONERS  
 416 North State Street  
 Jackson, Mississippi 39201

WATER WELL DRILLERS LOG

date well completed 10-13 1980 firm name Fontwell Supply county well located Marshall

LANDOWNER: Mt. Moriah Church  
Holly Springs Miss.  
 (mailing address)

description of formations encountered	depth	
	from	to
Clay	0	15
Sand	15	90
Clay	90	110
Sand	110	200
Clay	200	205
Sand	205	250

WELL LOCATION:  
 sec. 4 T 6 N R. 4 E  
2 miles N of Shushier  
 (distance) (direction) (nearest town)

WELL PURPOSE: Church  
 (home, irrigation, municipal, industrial)

WELL COMPLETION DATA:

(1) diameter (inches) 4

(2) total depth (feet) 250

(3) static water level (feet) 190 below above top of ground:

(4) casing Pvc, 240  
 (material) (depth)

         If telescope see back.  
 (size)

(5) screen 10ft, 240  
 (length) (depth to top)

6"  
 (size) (material)

(6) pump 3/4, 12  
 (HP) (yield gpm)

Elc  
 (type power)

(7) electric log NO  
 (yes or no)

          
 (organization running log)

(8) how well bottom plugged Cap.

DRILLERS REMARKS:


DEPT. OF NATURAL RESOURCES  
 BUREAU OF LAND & WATER RESOURCES

MAR - 6 1980

RECEIVED

If well telescopes please sketch and show depths.

GROUND LEVEL

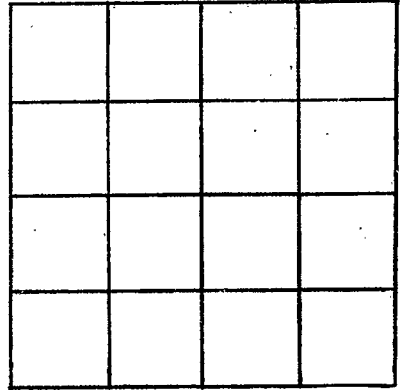

SECTION \_\_\_\_\_

Please indicate well location X.

ADDITIONAL INFORMATION

If more than one screen, show locations of each on sketch.