

MISSISSIPPI DEPARTMENT OF NATURAL RESOURCES

Bureau of Land and Water Resources

Southport Mall

P.O. Box 10631

Jackson, Mississippi 39209

WATER WELL DRILLERS LOG

Marshall
V 2012
9-10-81

HICKS WELL CO.

Marshall

9-10 19 81
 date well completed

Rt. 1, Box 157
 Senatobia, MS 38668

county well located

LANDOWNER: A.D. Smith
Rt. 2 Box 20
Senatobia, Ms. 38668
 (mailing address)

description of formations encountered	from	to
<u>Red Clay</u>	<u>0</u>	<u>10</u>
<u>Red Sand</u>	<u>10</u>	<u>50</u>
<u>white sand</u>	<u>50</u>	<u>240</u>

WELL LOCATION:
 sec. 18 T 6 N R 4 E
1 miles N of Harmon
 (distance) (direction) (nearest town)

WELL PURPOSE: Home
 (home, irrigation, municipal, industrial)

WELL COMPLETION DATA:

- (1) diameter (inches) 4
- (2) total depth (feet) 246
- (3) static water level (feet) 160 below above top of ground.
- (4) casing PVC 240
 (material) (depth)
- (size) if telescope see back.
- (5) screen 10 230
 (length) (depth to top)
4" slotted PVC
 (size) (material)
- (6) pump 3/4 10
 (HP) (yield gpm)
220V
 (type power)
- (7) electric log No
 (yes or no)

(organization running log)

(8) how well bottom plugged Cup

DRILLERS REMARKS:


DEPT. OF NATURAL RESOURCES
 BUREAU OF LAND & WATER RESOURCES

SEP 24 1981

RECEIVED

If well telescopes please sketch and show depths.

GROUND LEVEL

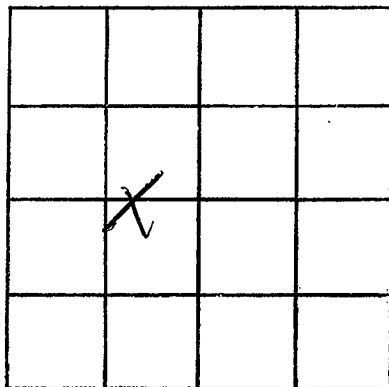

SECTION 18

Please indicate well location X.

ADDITIONAL INFORMATION

If more than one screen,
show locations of each on sketch.