

MISSISSIPPI DEPARTMENT OF NATURAL RESOURCES

Bureau of Land and Water Resources

Southport Mall

P.O. Box 10631

Jackson, Mississippi 39209

WATER WELL DRILLERS LOG

MARSHALL
V 2013

6/14 1984
date well completed

WILKINS WELL CO.
firm name 157

Marshall
county well located

LANDOWNER: Lynn Browning
Rt. 5
Holly Springs, Ms. 38635
(mailing address)

description of formations encountered	668	
	from	to
Red Clay	0	10
Red Sand	10	58
White Sand	50	155

WELL LOCATION:
sec. 13 T 6 N R 5 E
1 1/2 miles S of Saus Hill
(distance) (direction) (nearest town)

WELL PURPOSE: Home
(home, irrigation, municipal, industrial)

WELL COMPLETION DATA:

(1) diameter (inches) 4

(2) total depth (feet) 155

(3) static water level (feet) 100 below top of ground.

(4) casing PVC 155
(material) (depth)
4" if telescope see back.
(size)

(5) screen 10' 145'
(length) (depth to top)
0.015 PVC
(size) (material)

(6) pump 1/2 10
(HP) (yield gpm)
2200
(type power)

(7) electric log No
(yes or no)

(organization running log)

(8) how well bottom plugged Cap

DRILLERS REMARKS:


DEPT. OF NATURAL RESOURCES
BUREAU OF LAND & WATER RESOURCES

JUL 10 1984

RECEIVED

If well telescopes please sketch and show depths.

GROUND LEVEL

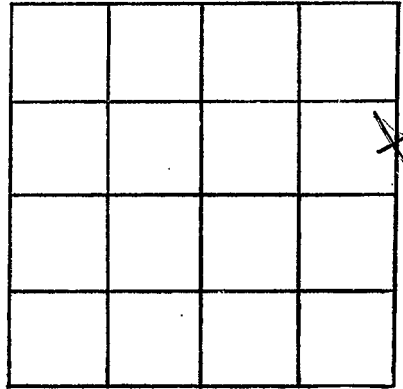

SECTION 13

Please indicate well location X.

ADDITIONAL INFORMATION

If more than one screen, show locations of each on sketch.