

MISSISSIPPI DEPARTMENT OF NATURAL RESOURCES

Bureau of Land and Water Resources

Southport Mall

P.O. Box 10631

Jackson, Mississippi 39209

WATER WELL DRILLERS LOG

Marshall  
 ✓  
 2014

HICKS WELL CO.

Marshall

11-20 1984  
 date well completed

firm name 15/  
 Sanatobia 148 30000

county well located

LANDOWNER: Don Bell  
 Rt. 5 Lawes Hill  
 Holly Springs, Ms. 38635  
 (mailing address)

description of formations encountered

from

to

Red Clay	0	20
Red Sand	20	30
White Sand + Clay	30	150
White Sand	150	170

WELL LOCATION:

sec. 13 T 6 N R 4 E  
 2 miles S of Lawes Hill  
 (distance) (direction) (nearest town)

WELL PURPOSE: Home  
 (home, irrigation, municipal, industrial)

WELL COMPLETION DATA:

- (1) diameter (inches) 4
- (2) total depth (feet) 170
- (3) static water level (feet) 120 below top of ground.
- (4) casing PVC 170 (material) (depth)  
 4" (size) if telescope see back.
- (5) screen 10' 180' (length) (depth to top)  
 816 PVC (size) (material)
- (6) pump 3/4 10 (HP) (yield gpm)  
 220V (type power)
- (7) electric log No (yes or no)

(organization running log)


(8) how well bottom plugged Cap

DRILLERS REMARKS:

MISSISSIPPI DEPARTMENT OF NATURAL RESOURCES  
 BUREAU OF LAND AND WATER RESOURCES  
 NOV 28 1984  
 RECEIVED

If well telescopes please sketch and show depths.

GROUND LEVEL

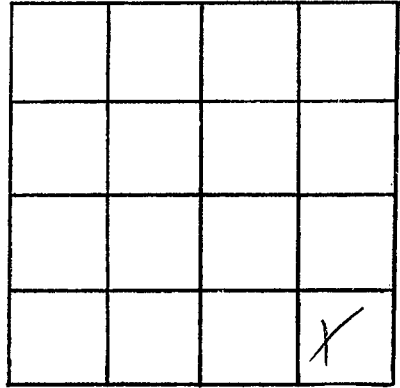

SECTION 13

Please indicate well location X.

ADDITIONAL INFORMATION

If more than one screen, show locations of each on sketch.