

MISSISSIPPI DEPARTMENT OF NATURAL RESOURCES

Bureau of Land and Water Resources

Southport Mall

P.O. Box 10631

Jackson, Mississippi 39209

WATER WELL DRILLERS LOG

Marshall
V 2016
6-9-85

6-9 date well completed 1985 Gullett Water Well firm name Marshall county well located

LANDOWNER: Encwood, William  
Rt 1 Box 114A  
Waterford, Ms 38685  
 (mailing address)


WELL LOCATION:  
 sec 13 T 6 N R 4 E  
1/8 miles North of Waterford  
 (distance) (direction) (nearest town)

WELL PURPOSE: Home  
 (home, irrigation, municipal, industrial)

WELL COMPLETION DATA:

(1) diameter (inches) 4"  
 (2) total depth (feet) 185'  
 (3) static water level (feet) 150' below above top of ground  
 (4) casing 175' (material) (depth)  
4" If telescope see back. (size)  
 (5) screen 10ft 175' (length) (depth to top)  
4" (size) (material)  
 (6) pump 3/4 10 (HP) (yield gpm)  
 (type power)  
 (7) electric log yes or no  
 (organization running log)  
 (8) how well bottom plugged Cap

description of formations encountered	from	to
<u>Top soil</u>	<u>0</u>	<u>2</u>
<u>Red Sand Old Clay</u>	<u>2</u>	<u>40</u>
<u>white sand and clay</u>	<u>40</u>	<u>120</u>
<u>white sand</u>	<u>120</u>	<u>185</u>

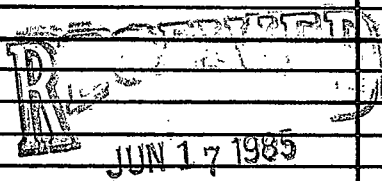


Department of Natural Resources  
 Bureau of Land & Water Resources

DRILLERS REMARKS:

If well telescopes please sketch and show depths.

GROUND LEVEL

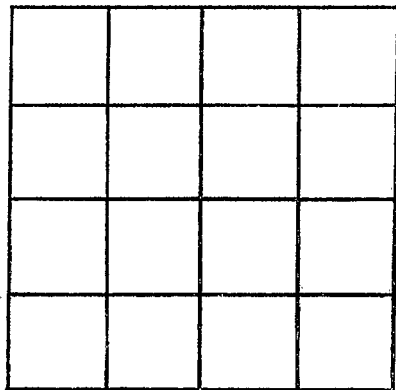

SECTION \_\_\_\_\_

Please indicate well location X.

ADDITIONAL INFORMATION

If more than one screen,  
show locations of each on sketch.