

MISSISSIPPI DEPARTMENT OF ENVIRONMENTAL QUALITY

Office of Land and Water Resources

P. O. Box 10631
Jackson, MS 39289-0631
WATER WELL DRILLERS LOG

COUNTY WELL LOCATED
MARSHALL

WELL NUMBER CODED
V 2034

DATE WELL COMPLETED
9-10-97

HICK WATER WELL CO.
NAME
**30242 HWY. 4 EAST
SENATOBIA, MS 38668**

NAME & MAILING ADDRESS OF LANDOWNER
F. GRANT MINOR

2520 Hwy 310

Waterford, MS 38685

WELL LOCATION: SEC TOWNSHIP RANGE
12 6 N 4 E

DISTANCE DIRECTION NEAREST TOWN
1/2 Miles E of Laws Hill

OTHER LANDMARK

WELL PURPOSE: Home, Irrigation, Municipal, Industrial, Fish Pond, etc.

PUMP DATA

PUMP TYPE (Circle One):
Submersible Turbine, Jet, Flowing Well,
Other (Describe)

POWER TYPE (Circle One):
Electric, Tractor, Diesel, Gasoline, 3/4 Butane,
Other (Describe) H/P

Pump Capacity (GPM) No. of Stages Setting Depth
12 **140** FT.

PUMP TEST

Well yielded _____ GPM with
a drawdown of no ft.
after Test hours of pumping

WELL DATA

Well Depth 183	Casing Diameter (In.) 4	Casing Length (Ft.) 173
Type of Casing PVC	Hole Depth 183	Depth to Static Water Level 100

TYPE OF COMPLETION: (Circle One or More):
Gravel Packed, Underreamed, Telescoped,
Natural Development, Open Hole, Other
(Describe)

WELL GROUTED TO A DEPTH OF 3 FEET
Type Grout (circle one) Cement, Bentonite, or Mix

LOG DATA

TYPE OF LOG RUN (Circle One): No Log Run
Electric, Gamma Ray, Density, Sonic, Neutron,
Other (Describe)

Name of Organization Running Log

SCREEN DATA

Diameter - Inches 4	Length - Feet 10	Slot Size - Inches .013
Screen Type PVC Slot	Depth to Bottom - Feet 173	

GEOLOGIC DATA (Office Use Only)

Surface Elev.	Geologic Unit	Unit Thickness	Depth to Top
Subs. SWL	Date	Analysis	Aquifer Test

Driller's Remarks

Top of Lap Pipe or Reduction in Casing
3 FEET IF TELESCOPED OR MORE THAN
ONE SCREEN, USE BACK PAGE

DESCRIPTION OF FORMATIONS ENCOUNTERED	FROM	TO
Red Clay	0	10
Red Sand	10	15
White Sand & Clay	15	110
White Sand	110	183

FORMATIONS (Continued)


NOV 17 1997

Dept. of Environmental Quality
Office of Land & Water Resources

IF MORE SPACE IS NEEDED, USE BACK

If well telescopes please sketch and show depths.

GROUND LEVEL

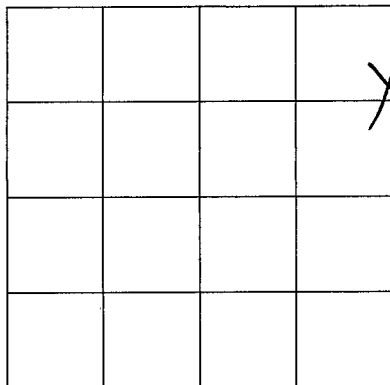

SECTION 12

Please indicate well location X.

ADDITIONAL INFORMATION

If more than one screen,
show location of each on sketch.