

MISSISSIPPI DEPARTMENT OF ENVIRONMENTAL QUALITY

Office of Land and Water Resources

P. O. Box 10631
Jackson, MS 39289-0631
WATER WELL DRILLERS LOG

COUNTY WELL LOCATED MARSHALL	
WELL NUMBER V 2035	CODED
DATE WELL COMPLETED 2-1-99	

PERMIT NUMBER
NAME OF DRILLING FIRM HICKS WELL CO.

NAME & MAILING ADDRESS OF LANDOWNER Tim Lamb			
1680 Odell Rd.			
Holly Springs, MS 3835			
WELL LOCATION	SEC	TOWNSHIP	RANGE
	4	6 S	4 W
DISTANCE	DIRECTION	NEAREST TOWN	
4 Miles	S	Chula Bona	
OTHER LANDMARK			
WELL PURPOSE: <u>Home</u> Irrigation, Municipal, Industrial, Fish Pond, etc.			

PUMP DATA		
PUMP TYPE (Circle One): <u>Submersible</u> Turbine, Jet, Flowing Well, Other (Describe)		
POWER TYPE (Circle One): <u>Electric</u> Tractor, Diesel, Gasoline, <u>1/2</u> Butane, Other (Describe) H/P <u>1/2</u>		
Pump Capacity (GPM)	No. of Stages	Setting Depth
10		100 FT.
PUMP TEST		
Well yielded _____ GPM with a drawdown of <u>10</u> ft. <u>10</u> after _____ hours of pumping		

WELL DATA		
Well Depth	Casing Diameter (In.)	Casing Length (Ft.)
192	4	182
Type of Casing	Hole Depth	Depth to Static Water Level
PVC	192	60

LOG DATA			
TYPE OF LOG RUN (Circle One): <u>No Log Run</u> Electric, Gamma Ray, Density, Sonic, Neutron, Other (Describe)			
Name of Organization Running Log			

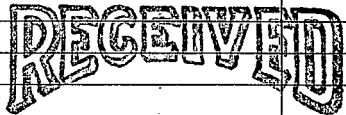
TYPE OF COMPLETION: (Circle One or More):
Gravel Packed Underreamed, Telescoped,
Natural Development, Open Hole, Other
(Describe)

GEOLOGIC DATA (Office Use Only)			
Surface Elev.	Geologic Unit	Unit Thickness	Depth to Top
Subs. SWL	Date	Analysis	Aquifer Test

WELL GROUTED TO A DEPTH OF 3 FEET
Type Grout (circle one): Cement, Bentonite, or Mix

Driller's Remarks	
Top of Lap Pipe or Reduction in Casing	
FEET	IF TELESCOPED OR MORE THAN ONE SCREEN: USE BACK PAGE

SCREEN DATA		
Diameter - Inches	Length - Feet	Slot Size - Inches
4	10	10/14
Screen Type	Depth to Bottom - Feet	
PVC slot	182	

DESCRIPTION OF FORMATIONS ENCOUNTERED	FROM	TO	FORMATIONS (Continued)	FROM	TO
Red + white Clay	0	10	 APR 02 1999 Dept. of Environmental Quality Office of Land & Water Resources		
Red Sand	10	70			
White Clay + Sand	70	130			
White Sand	130	192			

IF MORE SPACE IS NEEDED, USE BACK

If well telescopes please
sketch and show depths.

GROUND LEVEL

			X

SECTION 4

Please indicate well location X.

ADDITIONAL INFORMATION

If more than one screen,
show location of each on sketch.