

MISSISSIPPI DEPARTMENT OF ENVIRONMENTAL QUALITY

Office of Land and Water Resources

P. O. Box 10631
Jackson, MS 39289-0631
WATER WELL DRILLERS LOG

COUNTY WELL LOCATED MARSHALL	
WELL NUMBER V 2036	CODED
DATE WELL COMPLETED 11-3-99	

PERMIT NUMBER
NAME OF DRILLING FIRM HICKS WELL CO.

NAME & MAILING ADDRESS OF LANDOWNER Jimmy Whiteside			
1792 Brookhaven Dr			
Southaven, MS 38671			
WELL LOCATION	SEC.	TOWNSHIP	RANGE
	11	6 N	4 E
DISTANCE	DIRECTION	NEAREST TOWN	
1 Miles	W	of Laws Hill	
OTHER LANDMARK			
WELL PURPOSE <u>Home</u> Irrigation, Municipal, Industrial, Fish Pond, etc.			

PUMP DATA		
PUMP TYPE (Circle One): <u>Submersible</u> , Turbine, Jet, Flowing Well, Other (Describe)		
POWER TYPE (Circle One): <u>Electric</u> , Tractor, Diesel, Gasoline, <u>3/4</u> Butane, Other (Describe) H/P		
Pump Capacity (GPM) 10	No. of Stages	Setting Depth 255 FT.
PUMP TEST		
Well yielded _____ GPM with a drawdown of <u>no test</u> ft. after _____ hours of pumping		

WELL DATA		
Well Depth 261	Casing Diameter (In) 4	Casing Length (Ft) 251
Type of Casing PVC	Hole Depth 261	Depth to Static Water Level 220
TYPE OF COMPLETION: (Circle One or More): <u>Gravel Packed</u> , Underreamed, Telescoped, Natural Development, Open Hole, Other (Describe)		
WELL GROUTED TO A DEPTH OF 3 FEET. Type Grout (circle one): Cement, <u>Bentonite</u> , or Mix		

LOG DATA	
TYPE OF LOG RUN: (Circle One): Electric, Gamma Ray, Density, Sonic, <u>No Log Run</u> , Other (Describe)	
Name of Organization Running Log	

SCREEN DATA		
Diameter - Inches 4	Length - Feet 10	Slot Size - Inches .014
Screen Type PVC slot	Depth to Bottom - Feet 251	


GEOLOGIC DATA (Office Use Only)			
Surface Elev	Geologic Unit	Unit Thickness	Depth to Top
Subs. SWL	Date	Analysis	Aquifer Test
Driller's Remarks			
Top of Lap Pipe or Reduction in Casing			
FEET		IF TELESCOPED OR MORE THAN ONE SCREEN: USE BACK PAGE	

DESCRIPTION OF FORMATIONS ENCOUNTERED	FROM	TO
Red Clay	0	5
Red Sand	5	15
White Sand & Clay	15	261

FORMATIONS (Continued)	PEROM	TO
DISCOVERED		
JAN 04 2000		
Dept. of Environmental Quality Office of Land & Water Resources		
IF MORE SPACE IS NEEDED, USE BACK		

If well telescopes please sketch and show depths.

GROUND LEVEL

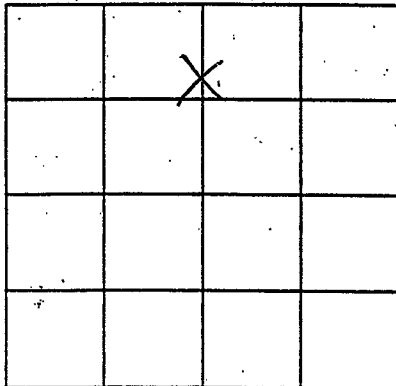

SECTION 11

Please indicate well location X.

ADDITIONAL INFORMATION

REGISTERED

1905 47 333

Office of Environmental Health
Department of Health Services

If more than one screen, show location of each on sketch.