

MISSISSIPPI
BOARD OF WATER COMMISSIONERS
416 North State Street
Jackson, Mississippi 39201

CODED

Marshall
W 2
2-10-70

WATER WELL DRILLERS LOG

2-10-19 70 Pompa Well Co Marshall
date well completed firm name county well located

LANDOWNER:

James Cury
Waterford Miss.
(mailing address)

description of formations encountered

from to

clay 0 30
Sand 30 170

WELL LOCATION:

sec. 3 T 6 N R 3 E
5 miles S-W of Waterford
(distance) (direction) (nearest town)

WELL PURPOSE:

(home, irrigation, municipal, industrial)

WELL COMPLETION DATA:

(1) diameter (inches) 4"
(2) total depth (feet) 170 feet
(3) static water level (feet) 105 below above top of ground.
(4) casing PVC, 170 feet (material) (depth)

(size) if telescope see back.

(5) screen 6 ft, 164 feet (length) (depth to top)
4" gravel wall (size) (material)
(6) pump 3/4 HP, 10 (yield gpm)

(type power)

(7) electric log elect. (yes or no)

(organization running log)

(8) how well bottom plugged 4" cof.

DRILLERS REMARKS:


CODED

MAR 6 - 1970

MISS. BD. OF
WATER COMM.

If well telescopes please sketch and show depths.

GROUND LEVEL

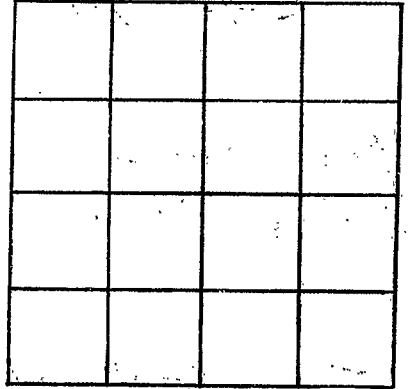

SECTION _____

Please indicate well location X.

ADDITIONAL INFORMATION

If more than one screen, show locations of each on sketch.