

MARSHALL

W-3

5-3-71

MISSISSIPPI BOARD OF WATER COMMISSIONERS
416 North State Street
Jackson, Mississippi 39201

WATER WELL DRILLERS LOG

CODED

May 3
date well completed

1971 R. L. Carpenter
firm name

Marshall
county well located

LANDOWNER: W. M. Major
Waterford, Miss.
RFD
(mailing address)

description of formations encountered	from	to
Surface Soil	0	15
White Coarse Sand	15	29
med. white sand	29	65
white clay	65	80
white coarse sand	80	120

WELL LOCATION:
sec. 14 T 6 N R 3 E
5 miles East of Lane Hill
(distance) (direction) (nearest town)

WELL PURPOSE: Home
(home, irrigation, municipal, industrial)

WELL COMPLETION DATA:

- (1) diameter (inches) 4 in
- (2) total depth (feet) 120
- (3) static water level (feet) 68 below top of ground.
- (4) casing Plastic, 114 ft
(material) (depth)
(size) If telescope see back.
- (5) screen 6 ft, 114 ft
(length) (depth to top)
4 in, Plastic & Lead
(size) (material)
- (6) pump 1/2 8
(HP) (yield gpm)
Elec.
(type power)
- (7) electric log No
(yes or no)

(organization running log)

(8) how well bottom plugged Plastic


SEP 2 1971

DRILLERS REMARKS:

MISS. BD. OF WATER COMM.

If well telescopes please sketch and show depths.

GROUND LEVEL

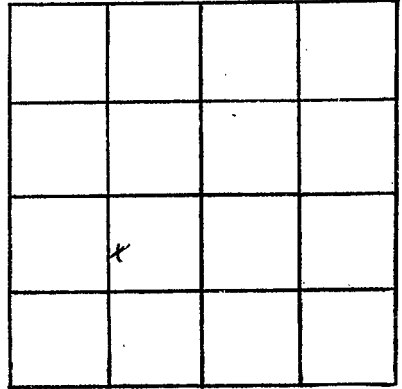

SECTION 11

Please indicate well location X.

ADDITIONAL INFORMATION

If more than one screen, show locations of each on sketch.