

Marshall
W 4
6-68

MISSISSIPPI
BOARD OF WATER COMMISSIONERS
416 North State Street
Jackson, Mississippi 39201

CODED

WATER WELL DRILLERS LOG

June 14 1968 Bumpas Well Co Marshall
date well completed firm name county well located

LANDOWNER: John Pujan

Waterford, Miss.

(mailing address)

description of formations encountered

from to

Red Clay
Sand

0 15
15 180

WELL LOCATION:


sec. 7 T. 6 N. R. 3 E.
2 miles E of Saus Hill
(distance) (direction) (nearest town)

WELL PURPOSE: Dwelling House
(home, irrigation, municipal, industrial)

WELL COMPLETION DATA:

- (1) diameter (inches) 4"
- (2) total depth (feet) 180 ft.
- (3) static water level (feet) 120 ^{below}/_{above} top of ground.
- (4) casing plastic, 174 ft.
(material) (depth)
no if telescope see back.
(size)
- (5) screen 6 ft., 174 ft.
(length) (depth to top)
009, gravel wall
(size) (material)
- (6) pump 3/4, 10 gpm
(HP) (yield gpm)
Elect.
(type power)
- (7) electric log yes or no
(organization running log)
- (8) how well bottom plugged plastic cap


CODED

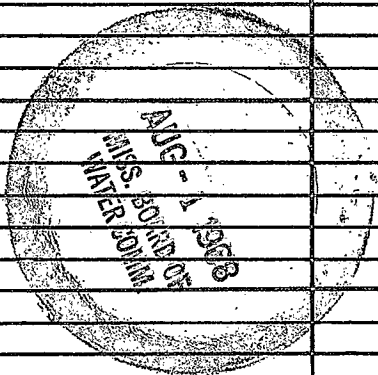

DRILLERS REMARKS:

If well telescopes please sketch and show depths.

GROUND LEVEL

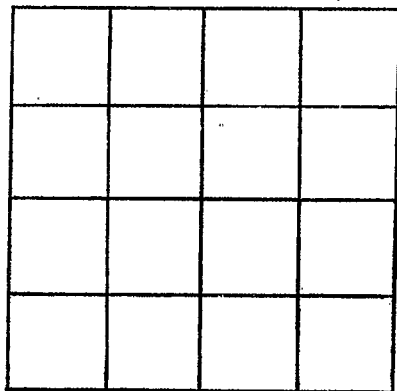

SECTION _____

Please indicate well location X.

ADDITIONAL INFORMATION

If more than one screen,
show locations of each on sketch.