

MARSHALL
W 6
4-3-72

MISSISSIPPI
 BOARD OF WATER COMMISSIONERS
 416 North State Street
 Jackson, Mississippi 39201

CODED

WATER WELL DRILLERS LOG

4-3-72 19 C. & H. Well Co. MARSHALL
 date well completed firm name county well located



LANDOWNER: <u>LRA JONES</u>	description of formations encountered	from	to
<u>RT-1 Box 30</u>			
<u>WATERFORD MISS.</u> (mailing address)	<u>Red SAND</u>	<u>0</u>	<u>15</u>
	<u>" "</u>	<u>15</u>	<u>30</u>
WELL LOCATION:	<u>WHITE SAND</u>	<u>30</u>	<u>60</u>
sec. <u>1</u> T. <u>6</u> N. R. <u>3</u> E	<u>BLACK CLAY</u>	<u>60</u>	<u>270</u>
<u>1/4</u> miles <u>SOUTH</u> of <u>WATERFORD</u> (distance) (direction) (nearest town)	<u>BLACK CLAY WITH TRACE SAND</u>	<u>270</u>	<u>285</u>
WELL PURPOSE: (home, irrigation, municipal, industrial)			
WELL COMPLETION DATA:			
(1) diameter (inches) <u>4 1/2</u>			
(2) total depth (feet) <u>285</u>			
(3) static water level (feet) <u>45</u> below top of ground.			
(4) casing <u>PLASTIC</u> , <u>265</u> (material) (depth)			
<u> </u> (size) if telescope see back.			
(5) screen <u>Slotted</u> , <u>20' 2 1/2</u> (length) (depth to top)			
<u>4 1/2"</u> , <u>PLASTIC</u> (size) (material)			
(6) pump <u>3/4</u> , <u>10 GPM</u> (HP) (yield gpm)			
<u>220 FIRC</u> (type power)			
(7) electric log <u>NO</u> (yes or no)			
<u> </u> (organization running log)			
(8) how well bottom plugged <u>CAP</u>			
DRILLERS REMARKS: <u>OVER</u>			

CODED

APR 10 1972

MISS. DD-1
 REPRODUCED FROM

If well telescopes please sketch and show depths.

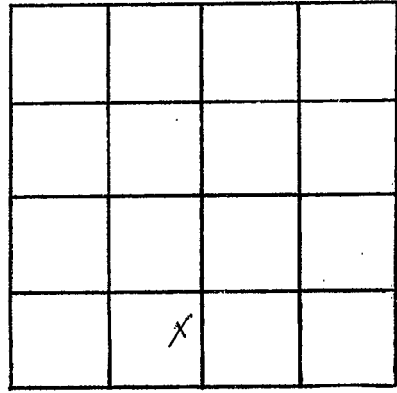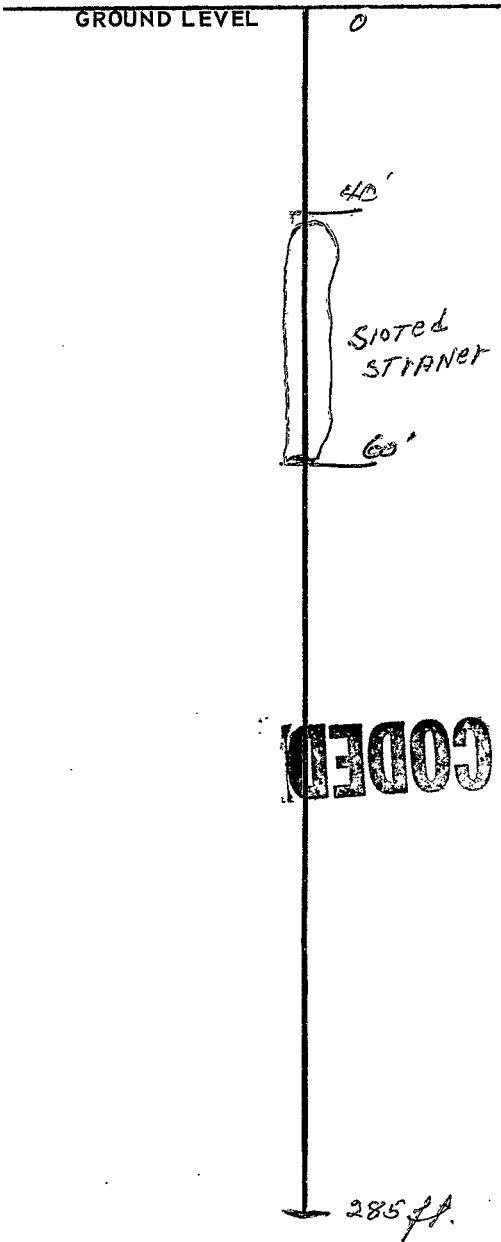

SECTION 1

Please indicate well location X.

ADDITIONAL INFORMATION

Cased Bottom
Set Strainer from 40 to 60 ft. at top

If more than one screen, show locations of each on sketch.