

MARSHALL
W7
4-1-72

MISSISSIPPI
BOARD OF WATER COMMISSIONERS
416 North State Street
Jackson, Mississippi 39201

CODED

WATER WELL DRILLERS LOG

4-1 1972 Dean Kent Boyer Marshall
date well completed firm name county well located

LANDOWNER:
Annie Bell Cummings
Holly Springs, Miss.
(mailing address)

description of formations encountered	from	to
<u>clay</u>	<u>0</u>	<u>10</u>
<u>sand</u>	<u>10</u>	<u>80</u>

WELL LOCATION:
sec. 2 T. 6 N. R. 3 E.
14 miles South of Holly Springs
(distance) (direction) (nearest town)

WELL PURPOSE: Drinking
(home, irrigation, municipal, industrial)

- WELL COMPLETION DATA:
- (1) diameter (inches) 4"
 - (2) total depth (feet) 80 feet
 - (3) static water level (feet) 65' below above top of ground.
 - (4) casing PVC, 80' x 1"
(material) (depth)
(size) if telescope see back.
 - (5) screen 8 feet, 92'
(length) (depth to top)
4", gravel wall
(size) (material)
 - (6) pump 3/4, 10
(HP) (yield gpm)
(type power)
 - (7) electric log elect
(yes or no)
(organization running log)
 - (8) how well bottom plugged 4" cap


CODED

DRILLERS REMARKS:

MAY 10 1972

If well telescopes, please sketch and show depths.

GROUND LEVEL

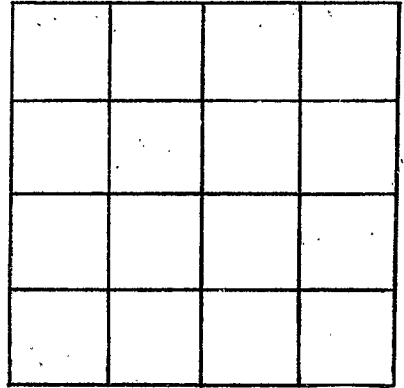

SECTION _____

Please indicate well location X.

ADDITIONAL INFORMATION

If more than one screen, show locations of each on sketch.