

MARSHALL

W 8

9-14-73

MISSISSIPPI BOARD OF WATER COMMISSIONERS  
416 North State Street  
Jackson, Mississippi 39201

CODED

WATER WELL DRILLERS LOG

9-14 1973  
date well completed

Don Kent Burfoot  
firm name

Marshall  
county well located

LANDOWNER:  
Alden Moore  
Waterford, Miss.  
(mailing address)

description of formations encountered	from	to
	clay	0
Sand	20	130

WELL LOCATION:  
sec. 10 T. 6 N. R. 3 E  
5 miles South of Waterford  
(distance) (direction) (nearest town)

WELL PURPOSE: Drilling  
(home, irrigation, municipal, industrial)

- WELL COMPLETION DATA:
- (1) diameter (inches) 4"
  - (2) total depth (feet) 130 feet
  - (3) static water level (feet) 74 below above top of ground.
  - (4) casing PVC 130 feet (material) (depth)
  - (size) if telescope see back.
  - (5) screen 74" 123 feet (length) (depth to top)
  - 4" gravel sand (size) (material)
  - (6) pump 3/4 HP 14 (yield gpm)
  - (type power)
  - (7) electric log No (yes or no)
  - (organization running log)
  - (8) how well bottom plugged 4" cap


CODED

DRILLERS REMARKS:

OCT 9 1973

If well telescopes please sketch and show depths.

GROUND LEVEL

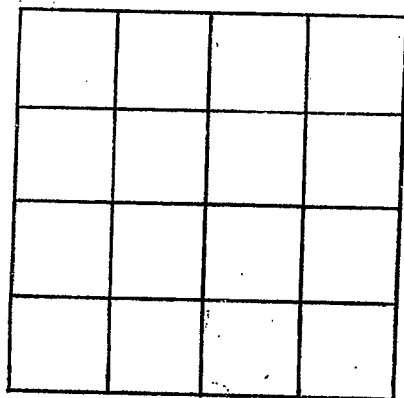

SECTION \_\_\_\_\_

Please indicate well location X.

ADDITIONAL INFORMATION

If more than one screen,  
show locations of each on sketch.