

MARSHALL
W9
7-5-74

MISSISSIPPI
 BOARD OF WATER COMMISSIONERS
 416 North State Street
 Jackson, Mississippi 39201

CODED

WATER WELL DRILLERS LOG

7-5-1974 Wicks Bros. W.M.C. Marshall
 date well completed firm name county well located

LANDOWNER:

Alberta Adams-

description of formations encountered

from

to

Rt 1 Box 34 Waterford, Miss.
 (mailing address)

<u>Red clay</u>	<u>0</u>	<u>15</u>
<u>white sand + clay</u>	<u>15</u>	<u>45</u>
<u>white sand</u>	<u>45</u>	<u>140</u>

WELL LOCATION:

sec 12 T 6 N R 3 E
5 miles S of Waterford
 (distance) (direction) (nearest town)

WELL PURPOSE:

drinking
 (home, irrigation, municipal, industrial)

WELL COMPLETION DATA:

- (1) diameter (inches) 4 1/2
- (2) total depth (feet) 140
- (3) static water level (feet) 100 below top of ground.
- (4) casing Plastic 140
 (material) (depth)
 (size) if telescope see back.
- (5) screen 4 1/2 136
 (length) (depth to top)
1/2 brass
 (size) (material)
- (6) pump 1/2 10
 (HP) (yield gpm)
220
 (type power)
- (7) electric log no
 (yes or no)

CODED

(organization running log)

(8) how well bottom plugged cap

RECEIVED
REGISTERED


AUG - 2 1974

DRILLERS REMARKS:

MISS. BD. OF WATER COMM

If well telescopes please sketch and show depths.

GROUND LEVEL

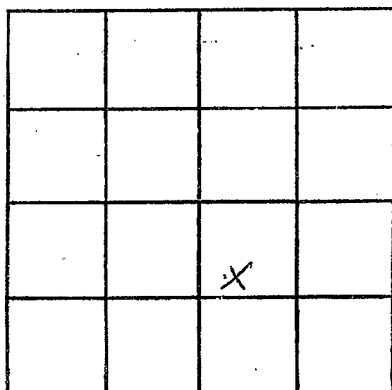

SECTION 12

Please indicate well location X.

ADDITIONAL INFORMATION

If more than one screen,
show locations of each on sketch.