

**MARSHALL**  
**W 10**  
**9-16-14**

MISSISSIPPI  
 BOARD OF WATER COMMISSIONERS  
 416 North State Street  
 Jackson, Mississippi 39201

**CODED**

**WATER WELL DRILLERS LOG**

9-16-1974 Bliss Bros. Well Co. Marshall  
 date well completed firm name county well located

**LANDOWNER:**

description of formations encountered

from

to

Urea Brown - Rt 2,  
Waterford, Miss.  
 (mailing address)

Red Clay	0	15
White Sand	15	45
Black Muds	45	140

**WELL LOCATION:**

sec. 2 T. 6 N. R. 3 E.  
1/2 miles NW of Malone  
 (distance) (direction) (nearest town)

**WELL PURPOSE:**

Same  
 (home, irrigation, municipal, industrial)

**WELL COMPLETION DATA:**


- (1) diameter (inches) 4 1/2 in.
- (2) total depth (feet) 140
- (3) static water level (feet) 30 below top of ground.
- (4) casing Plastic, 140  
 (material) (depth)  
 \_\_\_\_\_ if telescope see back.  
 (size)
- (5) screen 30, 30  
 (length) (depth to top)  
4 1/2 in., Slotted  
 (size) (material)
- (6) pump 1/2, 10  
 (HP) (yield gpm)  
Electric  
 (type power)
- (7) electric log No  
 (yes or no)  
 \_\_\_\_\_  
 (organization running log)
- (8) how well bottom plugged Clay

**RECEIVED**  
**SEP 25 1974**

**DRILLERS REMARKS:**

If well telescopes please sketch and show depths.

GROUND LEVEL

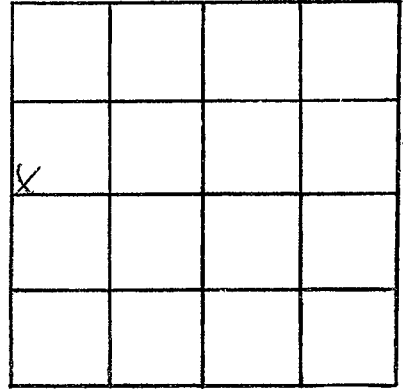

SECTION 2

Please indicate well location X.

ADDITIONAL INFORMATION

If more than one screen,  
show locations of each on sketch.