

March 28, 1977

MARSHALL

W 2000

15F  
Need  
date

MISSISSIPPI  
BOARD OF WATER COMMISSIONERS  
416 North State Street  
Jackson, Mississippi 39201

WATER WELL DRILLERS LOG

Atkinson + Frost

Marshall

date well completed

firm name

county well located

LANDOWNER: Willie F.

Wilson #2 Box 144A

Waterford Miss  
(mailing address) 38688

description of formations encountered

from to

Clay	0	18
sand	18	90
Clay	90	110
sand	110	180

WELL LOCATION:

sec. 5 T 6 N R 3 E  
1/2 mi SW of Waterford

WELL PURPOSE: home  
(home, irrigation, municipal, industrial)

WELL COMPLETION DATA:

- (1) diameter (inches) 4"
- (2) total depth (feet) 180
- (3) static water level (feet) 125 below top of ground
- (4) casing PVC, 180 (material) (depth)
- (5) screen 10' (length), 170' (depth to top), 4" PVC (size) (material)
- (6) pump 3/4 (HP), 10 (yield gpm), Elec. (type power)
- (7) electric log NO (yes or no)

(organization running log)

(8) how well bottom plugged CAP.

DRILLERS REMARKS:


RECEIVED

MAR 27 1977

MISS. BD. OF WATER COMMISSIONERS

If well telescopes please sketch and show depths.

GROUND LEVEL

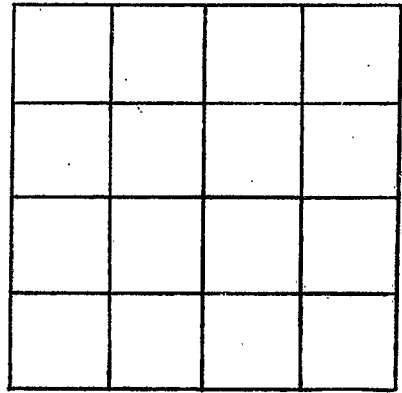

SECTION \_\_\_\_\_

Please indicate well location X.

ADDITIONAL INFORMATION

If more than one screen, show locations of each on sketch.