

MARSHALL

W 2001

6/14/78

MISSISSIPPI BOARD OF WATER COMMISSIONERS 416 North State Street Jackson, Mississippi 39201

WATER WELL DRILLERS LOG

6-14 1978 date well completed Hick Well Co firm name Marshal county well located

LANDOWNER: Lyle Dehart

3526 Clark Rd.

Memphis, TN (mailing address)

WELL LOCATION:

sec 11 T 6 N R 3 E #7 at #7 (distance) miles (direction) of (nearest town)


WELL PURPOSE: (home, irrigation, municipal, industrial)

WELL COMPLETION DATA:

- (1) diameter (inches) 4"
(2) total depth (feet) 140
(3) static water level (feet) 100 below top of ground
(4) casing PVC 140 (material), (depth)
(5) screen 7 133 (length), (depth to top)
4" gravel type (size), (material)
(6) pump 1/2 10 (HP), (yield gpm)
220V (type power)
(7) electric log No (yes or no)
(organization running log)
(8) how well bottom plugged Cap


Table with 3 columns: description of formations encountered, from, to. Rows include Red Clay (0-20), Red Sand (20-80), White sand (80-120), Black Clay (120-140).

DRILLERS REMARKS:

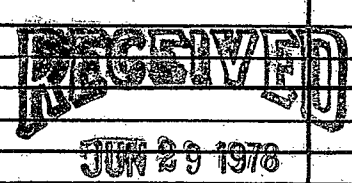

If well telescopes please sketch and show depths.

GROUND LEVEL

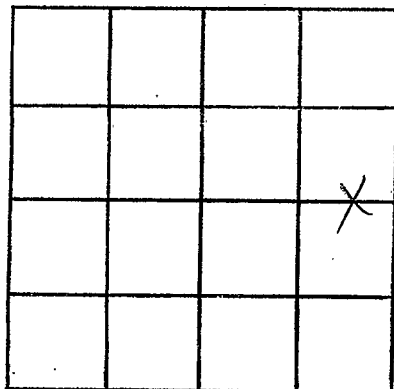

SECTION 11

Please indicate well location X.

ADDITIONAL INFORMATION

If more than one screen,
show locations of each on sketch.