

Marshall
 W 2002
 11-10-78
 11-10

MISSISSIPPI
 BOARD OF WATER COMMISSIONERS
 416 North State Street
 Jackson, Mississippi 39201

WATER WELL DRILLERS LOG

19 B. Atkinson & Fred Marshall
 date well completed firm name county well located

LANDOWNER: Wellton Marion
Waterford Miss.
 (mailing address)

WELL LOCATION:
 sec. 6 T. 6 N. R. 3 E
 (distance) miles of (direction) (nearest town)

description of formations encountered	from	to
	<u>Clay</u>	<u>0</u>
<u>Sand</u>	<u>12</u>	<u>25</u>
<u>Clay</u>	<u>25</u>	<u>30</u>
<u>Sand</u>	<u>30</u>	<u>60</u>

WELL PURPOSE: Home
 (home, irrigation, municipal, industrial)

- WELL COMPLETION DATA:
- (1) diameter (inches) 4"
 - (2) total depth (feet) 60
 - (3) static water level (feet) 30 below top of ground.
 - (4) casing PVC, 30
 (material) (depth)
 - 10' if telescope see back.
 (size)
 - (5) screen 10', 50
 (length) (depth to top)
1", PVC
 (size) (material)
 - (6) pump 1/2, 12
 (HP) (yield gpm)
Elc.
 (type power)
 - (7) electric log _____
 (yes or no)
 (organization running log)
 - (8) how well bottom plugged C.A.D.

Miss. Board of Water Comm.


APR 4 - 1979

RECEIVED

DRILLERS REMARKS:

If well telescopes please sketch and show depths.

GROUND LEVEL

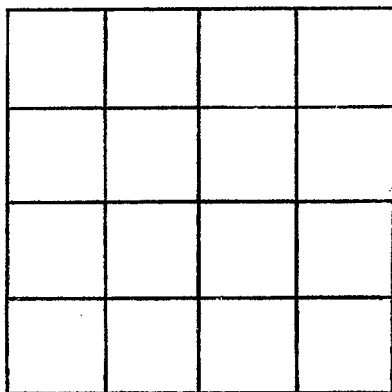

SECTION _____

Please indicate well location X.

ADDITIONAL INFORMATION

If more than one screen, show locations of each on sketch.