

MARSHALL

MISSISSIPPI
BOARD OF WATER COMMISSIONERS
416 North State Street
Jackson, Mississippi 39201

W-2003

WATER WELL DRILLERS LOG

7-31-79

7-31-79

date well completed

First Well Supply

firm name

Marshall

county well located

LANDOWNER: Marshall Motel

description of formations encountered

from

to

Waterford Miss

Clay

0 30

Sand

30 45

Clay

45 58

Sand

58 78

(mailing address)

WELL LOCATION:

sec. 5 T. 6 N. R. 3 E.
4 miles S of Waterford
(distance) (direction) (nearest town)

WELL PURPOSE: Home
(home, irrigation, municipal, industrial)

WELL COMPLETION DATA:

- (1) diameter (inches) 4
- (2) total depth (feet) 78
- (3) static water level (feet) 45 below top of ground.
- (4) casing PVC 68
(material) (depth)
4 1/2
(size) If telescope see back.
- (5) screen #104 68
(length) (depth to top)
4" PVC
(size) (material)
- (6) pump 1/2 12
(HP) (yield gpm)
Electric
(type power)
- (7) electric log None
(yes or no)
- (organization running log)
- (8) how well bottom plugged Cap

DEPT. OF NATURAL RESOURCES
BUREAU OF LAND & WATER RESOURCES


MAR 13 1980

RECEIVED

DRILLERS REMARKS:

If well telescopes please sketch and show depths.

GROUND LEVEL

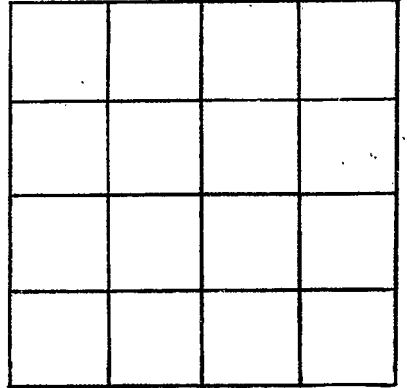

SECTION _____

Please indicate well location X.

ADDITIONAL INFORMATION

If more than one screen, show locations of each on sketch.