

MISSISSIPPI DEPARTMENT OF NATURAL RESOURCES

Bureau of Land and Water Resources

Southport Mall

P.O. Box 10631

Jackson, Mississippi 39209

WATER WELL DRILLERS LOG

Marshall
W 2004
4-21-81

4-21-81 date well completed Hicks Well Co. firm name Marshall county well located

LANDOWNER: Ray Canedy
Dobbs Drive
Memphis, TN
 (mailing address)

description of formations encountered	from	to
Red Clay	0	10
Red Sand	10	40
White Sand	40	150

WELL LOCATION:
 sec. 18 T. 6 N. R. 3 E.
1 1/2 miles S of Jacks Hill
 (distance) (direction) (nearest town)


WELL PURPOSE: Home
 (home, irrigation, municipal, industrial)

- WELL COMPLETION DATA:
- (1) diameter (inches) 4
 - (2) total depth (feet) 150
 - (3) static water level (feet) 100 below above top of ground.
 - (4) casing PVC 150
 (material) (depth)
 - If telescope see back.
 (size)
 - (5) screen 12 138
 (length) (depth to top)
4 granular & slotted
 (size) (material)
 - (6) pump 1/2 10
 (HP) (yield gpm)
270V
 (type power)
 - (7) electric log No
 (yes or no)

(organization running log)


(8) how well bottom plugged Cap

DRILLERS REMARKS:

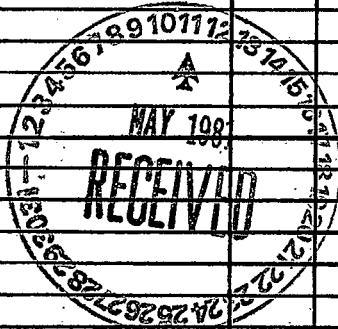

If well telescopes please sketch and show depths.

GROUND LEVEL

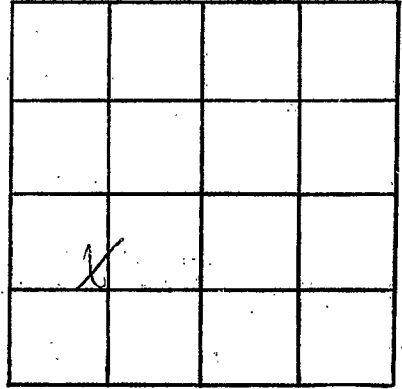

SECTION 18

Please indicate well location X.

ADDITIONAL INFORMATION

If more than one screen, show locations of each on sketch.