

MISSISSIPPI DEPARTMENT OF NATURAL RESOURCES

Bureau of Land and Water Resources

Southport Mall

P.O. Box 10631

Jackson, Mississippi 39209

WATER WELL DRILLERS LOG

HICKS WELL COMPANY

Marshall
W 2005
4-19-85

4-19 19 85
date well completed

PT. 1 BOX 157
firm name

Marshall
county well located

SENATOBIA MISS

LANDOWNER: John King

description of formations encountered

from to

Rt # 2

Waterford MS 38685
(mailing address)

Red Clay	0	10
Red Sand	10	30
White Sand & clay	30	100
White Sand	100	170

WELL LOCATION:

sec. 8 T. 6 N. R. 3 E
2 miles East of Marshall
(distance) (direction) (nearest town)

WELL PURPOSE: Home
(home, irrigation, municipal, industrial)

WELL COMPLETION DATA:

(1) diameter (inches) 4"

(2) total depth (feet) 170'

(3) static water level (feet) 80' below top of ground.

(4) casing PVC, 160' (depth)
4" (size) if telescope see back.

(5) screen 10' (length), 160' (depth to top)

.010 (size), PVC (material)

(6) pump 1/2 (HP), 10 (yield gpm)

220 V (type power)

(7) electric log No (yes or no)

(organization running log)

(8) how well bottom plugged Cap


DRILLERS REMARKS:

RECEIVED
JUL 1 - 1985

Department of Natural Resources
Bureau of Land & Water Resources

If well telescopes please sketch and show depths.

GROUND LEVEL

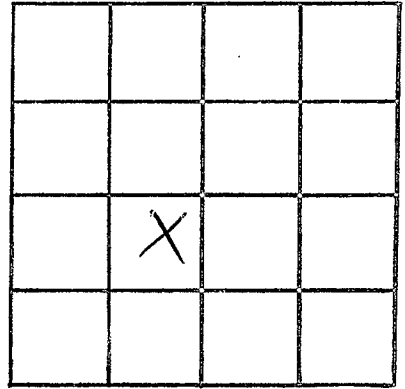

SECTION 8

Please indicate well location X.

ADDITIONAL INFORMATION

If more than one screen,
show locations of each on sketch.