

780.00
 tax 39.00
 819.00

Marshall
 X-7
 8-29-71

MISSISSIPPI
 BOARD OF WATER COMMISSIONERS
 416 North State Street
 Jackson, Mississippi 39201

CODED

WATER WELL DRILLERS LOG

8-29-1971 date well completed
 J I Medlin firm name
 Marshall county well located

LANDOWNER:	Description of formations encountered	from	to
Prepared Risk Insures	white clay	0	13
Ray Shopping Center New	yellow "	13	37
(mailing address) Albany	1 sand	37	160

WELL LOCATION:
 sec. 12 T 6 N R 2 E
 4 miles west of Bethlehem

WELL PURPOSE:
 (home, irrigation, municipal, industrial)

- WELL COMPLETION DATA:
- (1) diameter (inches) 4
 - (2) total depth (feet) 160
 - (3) static water level (feet) 96 below top of ground.
 - (4) casing P 160 (material) (depth)
 - (size) If telescope see back.
 - (5) screen 10 150 (length) (depth to top)
 - (size) P (material)
 - (6) pump 1/2 7 (HP) (yield gpm)
 - (type power) E
 - (7) electric log (yes or no)
 - (organization running log)
 - (8) how well bottom plugged Cap

CODED


SEP 8 1971

MISS. BO. OF WATER COMMISSIONERS

DRILLERS REMARKS:

If well telescopes please sketch and show depths.

GROUND LEVEL

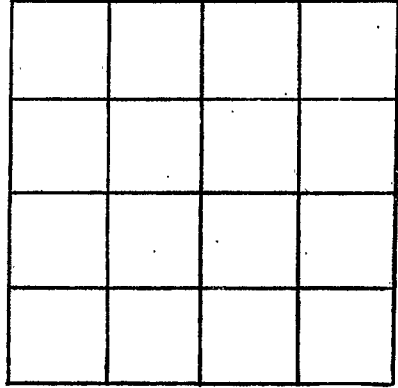

SECTION _____

Please indicate well location X.

ADDITIONAL INFORMATION

Lined area for providing additional information, consisting of 20 horizontal lines.

If more than one screen, show locations of each on sketch.